

CERTIFIED RECORD OF LAND CORNER MONUMENTATION


History of original corner establishment:

The corner was originally established by Arthur Philbrick under Mineral Survey No. 477, during June and July 1902. The original notes state that at the corner a scribed black pine post 4' long by 4" sq. was set 12" in the ground and surrounded with a mound of earth. From the corner:

A 6" black pine bears N36°35'W-11.15'.

A 4" black pine bears S26°W-15.73'.

Both marked B.T.E.F. 3-K. 2-477.

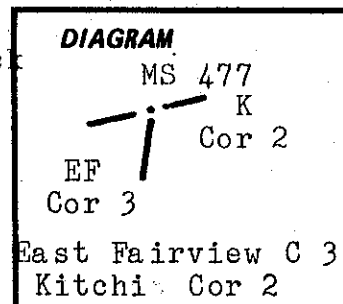

Description of corner evidence found:

Found a mound of earth with a hole in the middle with the remains of the post in the hole from which:

An 8" down lodgepole pine bears S26°W-15.7' with scribing visible on open blaze (original bearing tree).

Description of monument and accessories established to perpetuate the

original location of this corner:

Set a 2 1/2" by 30" aluminum pipe with a 2 1/2" aluminum cap 22" in the ground and surrounded with a mound of earth and stone. Placed the remains of the original post on the mound. From the monument:

A 7" alpine fir bears S33 1/2°E-4.8' scribed 3-EF-2-K-477 BT.

A 10" western larch bears N32 1/2°E-60.6' scribed 3-EF-2-K-477 BT.


New bearing trees have a brass washer stamped PLS 1106 nailed to the face of blaze. Attached signs 54-9 and 54-3 to each bearing tree and painted face of blaze and a 6" red band around each bearing tree. Set steel fence posts on National Forest Boundary NE and SW of corner and attached sign 54-9 to one post and sign 54-2 to both posts.

Used steel tape and staff compass with 20°E declination, measured to the center of the bearing trees.


This corner was remonumented on July 25, 1985.

Witness: John Tuttle


Cap is marked:

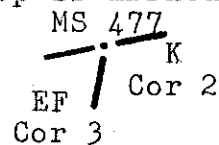

1985
PLS 1106

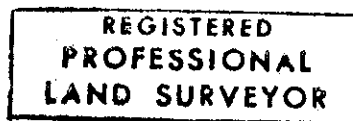

William R. Wells

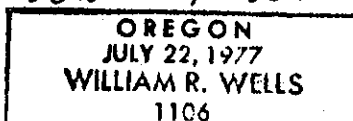

Office of.....County Surveyor..... County of.....Baker.....
State of.....Oregon..... I hereby certify that the within instrument was filed in this office
for record on the...27... day of.....Aug....., 1985
..... by
(COUNTY OFFICIAL) (DEPUTY)