


CERTIFIED RECORD OF LAND CORNER MONUMENTATION

History of original corner establishment:

The corner was originally established by Arthur Philbrick under Mineral Survey No. 477, during June and July 1902. The original notes state that at the corner a scribed black pine post 4' long by 4" sq. was set 12" in the ground from which:  
A 18" red fir bears S44°40'W-12.73'.  
A 6" black pine bears N36°W-3.70'.  
Both marked B.T.E.F.N.C.-477.

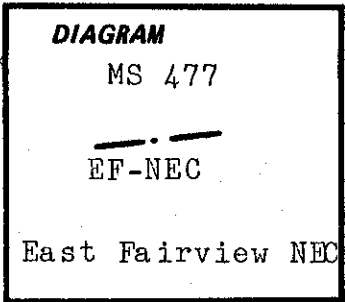

Description of corner evidence found:

Found a mound of stone and rotted remains of the post at the ground level from which:

A 20" douglas fir bears S44 3/4°W-13.0' with scribing visible on partly healed blaze. (original bearing tree).

Description of monument and accessories | established to perpetuate the original location of this corner:

Set a 2 1/2" by 30" aluminum pipe with a 2 1/2" aluminum cap 22" in the ground and surrounded with a mound of stone, from which:

A 9" white fir bears N14 1/2°E-21.2' scribed NEC-EF-477 BT.  
New bearing tree has a brass washer stamped PLS 1106 nailed to the face of blaze. Attached signs 54-3 and 54-9 to each bearing tree and painted face of blaze and a 6" red band around each bearing tree. Set steel fence posts on National Forest Boundary SW and NE of corner and attached sign 54-9 to one post and sign 54-2 to both posts.

Used steel tape and staff compass with 20°E declination, measured to the center of the bearing trees.


This corner was remonumented on July 25, 1985.

Witness: John Tuttle

Cap is marked:  
MS 477

— . —  
EF-NEC

1985  
PLS 1106

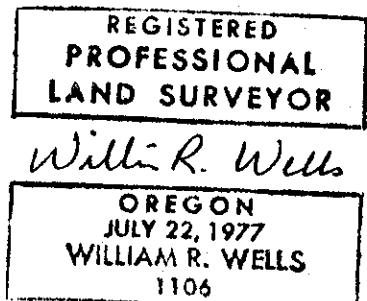

Office of...County Surveyor..... County of...Baker.....  
State of...Oregon....., I hereby certify that the within instrument was filed in this office  
for record on the...27... day of...Aug....., 19...85  
..... by .....  
(COUNTY OFFICIAL) (DEPUTY)