


CERTIFIED RECORD OF LAND CORNER MONUMENTATION

History of original corner establishment:

The corner was originally established by Arthur Philbrick under Mineral Survey No. 477, during June and July 1902. The original notes state that at the corner a scribed tamarack post 4' long by 4" sq. was set 12" in the ground and surrounded with a mound of earth from which:
A 14" red fir bears S69°09'E-85.54'.
An 8" black pine bears N0°50'W-88.32'.
Both marked B.T.E.F. 4-K. 1-477.

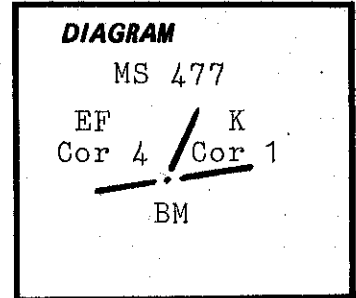

East Fairview Cor 4
Kitchi Cor 1

Description of corner evidence found:

Found a mound of earth with the remains of a rotted post in the hole at ground level from which:

An 18" western larch bears N0 3/4°E-88.8' with healed blaze (original bearing tree). The original notes call this a black pine.

Description of monument and accessories | established to perpetuate the original location of this corner:

Set a 2 1/2" by 30" aluminum pipe with a 2 1/2" aluminum cap 24" in the ground and surrounded with a mound of earth and stone, from which:


An 8" white fir bears N81 1/2°W-47.7' scribed 4-EF-1-K-477 BT.
New bearing tree has a brass washer stamped PLS 1106 nailed to the face of blaze. Attached sign 54-3 and 54-9 to each bearing tree and painted the face of blaze and a 6" red band around each bearing tree. Set a steel fence post on the claim line near the corner and attached sign 54-9.

Used steel tape and staff compass with 20°E declination, measured to the center of the bearing trees.


This corner was remonumented on July 26, 1985.

Witness: John Tuttle


Cap is marked:

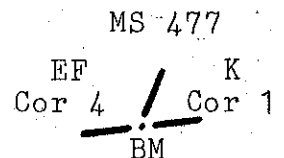

1985
PLS 1106

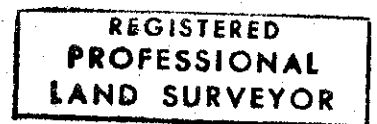

William R. Wells

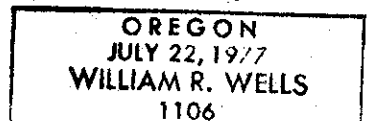

Office of.....County Surveyor.....County of.....Baker.....
State of.....Oregon....., I hereby certify that the within instrument was filed in this office
for record on the.....27..... day of.....Aug....., 1985
..... by
(COUNTY OFFICIAL) (DEPUTY)