


CERTIFIED RECORD OF LAND CORNER MONUMENTATION

History of original corner establishment:

The corner was originally established by Arthur Philbrick under Mineral Survey No. 477, during June and July 1902. The original notes state that at the corner a scribed tamarack post 4' long by 4" sq. was set 12" in the ground and surrounded with a mound of earth from which:
An 8" pine bears S40°15'W-11.8'.
An 8" black pine bears S70°45'E-12.82'.
Both marked B.T.K. 3-477.

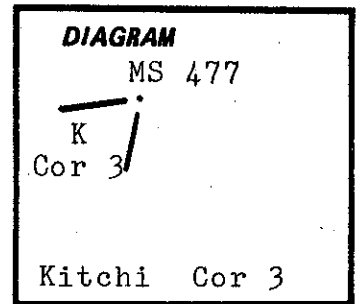

Description of corner evidence found:

Found a mound of earth with the remains of a rotted post underground from which:
A 9" down lodgepole pine bears S70 3/4°E-12.8' with scribing visible on open blaze (original bearing tree).

Description of monument and accessories | established to perpetuate the original location of this corner:

Set a 2 1/2" by 30" aluminum pipe with a 2 1/2" aluminum cap 15" in the ground and surrounded with a mound of earth and stone, from which:

A 7" alpine fir bears S6 1/2°E-24.9' scribed 3-K-477 BT.
A 12" western larch bears N53°W-35.2' scribed 3-K-477 BT.
New bearing trees have a brass washer stamped PLS 1106 nailed to the face of blaze. Attached signs 54-3 and 54-9 to each bearing tree and painted the face of blaze and a 6" red band around each bearing tree. Set steel fence posts on National Forest Boundary SW of corner and attached sign 54-9 to one post and sign 54-2 to both posts.

Used steel tape and staff compass with 20°E declination, measured to the center of the bearing trees.



This corner was remonumented on July 25, 1985.

Witness: John Tuttle

Cap is marked:

MS 477
K
Cor 3

1985
PLS 1106

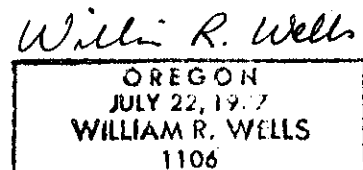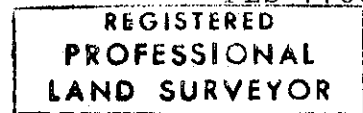

Office of... County Surveyor... County of... Baker
Oregon
State of... , I hereby certify that the within instrument was filed in this office
for record on the... 27... day of... Aug... , 1985
..... by
(COUNTY OFFICIAL) (DEPUTY)