


CERTIFIED RECORD OF LAND CORNER MONUMENTATION

**History of original corner establishment:**

The corner was originally established by Charles Foster under Mineral Survey No. 421, during August 1902. The original notes state that at the corner a scribed tamarack post  $4\frac{1}{2}$ ' long by 4" sq. was set 18" in the ground and surrounded with a mound of earth and stone from which: A 14" tamarack bears  $S19^{\circ}20'W-15.5'$  scribed ES-2-421-BT.

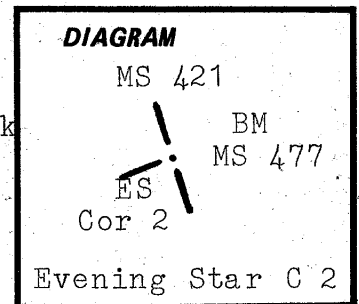

**Description of corner evidence found:**

Found remains of original post above ground and remains of original post in mound at ground level from which:

A 17" western larch bears  $N19\frac{1}{4}^{\circ}W-15.7'$  with scribing visible on partly healed blaze (original bearing tree).  
(The original notes call for the tree at  $S19^{\circ}20'W$ ).

**Description of monument and accessories I established to perpetuate the**

**original location of this corner:**

Set a  $2\frac{1}{2}$ " by 30" aluminum pipe with  $2\frac{1}{2}$ " aluminum cap 22" in the ground and surrounded with a mound of earth and stone. Place remains of original post on the mound. From the monument:

A 9" white fir bears  $N32^{\circ}E-19.6'$  scribed 2-ES-421-BT.

New bearing tree has a brass washer stamped PLS 1106 nailed to face of blaze. Attached sign 54-3 and 54-9 to each bearing tree and painted face of blaze and a 6" red band around each bearing tree. Set steel fence posts on National Forest Boundary SW and NW of corner and attached sign 54-9 to one post and sign 54-2 to both posts.

Used steel tape and staff compass with  $20^{\circ}E$  declination, measured to the center of the bearing trees.

This corner was remonumented on July 24, 1985.

Witness: John Tuttle

REGISTERED  
PROFESSIONAL  
LAND SURVEYOR

*William R. Wells*

OREGON  
JULY 22, 1977  
WILLIAM R. WELLS  
1106

Cap is marked:

MS 421

BM

MS 477

ES

Cor 2

1985  
PLS 1106

Office of..... County Surveyor..... County of..... Baker  
State of..... Oregon....., I hereby certify that the within instrument was filed in this office  
for record on the...27... day of..... Aug....., 1985  
..... by .....  
(COUNTY OFFICIAL) (DEPUTY)