


CERTIFIED RECORD OF LAND CORNER MONUMENTATION

History of original corner establishment:

The corner was originally established by Charles Foster under Mineral Survey No. 421, during August 1901. The original notes state that at the corner a scribed tamarack post $4\frac{1}{2}$ ' long by 4" sq. was set 18" in the ground and surrounded with a mound of earth from which:
A 30" tamarack bears S79°15'W-18'.
A 12" fir bears S23°30'E-28.6'.
Both marked Ibex-2-421-BT.

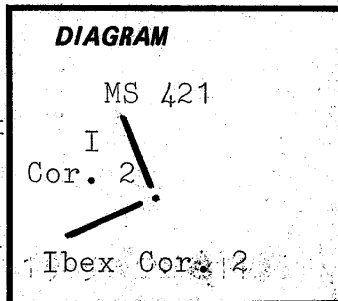

Description of corner evidence found:

Found a mound of stone with a hole in the middle and remains of rotted post in the mound from which:

A 32" western larch bears S79°15'W-19.0' with scribing visible on open blaze (original bearing tree).

Description of monument and accessories I established to perpetuate the original location of this corner:

Set a $2\frac{1}{2}$ " by 30" aluminum pipe with a $2\frac{1}{2}$ " aluminum cap 22" in the ground and surrounded with a mound of stone, from which:

An 8" white fir bears S33°W-31.4' scribed 2-I-421-BT.
New bearing tree has a brass washer stamped PLS 1106 nailed to the face of blaze. Attached signs 54-9 and 54-3 to each bearing tree and painted face of blaze and a 6" red band around each bearing tree. Set steel fence posts on National Forest Boundary NW and SW of corner and attached sign 54-9 to one post and sign 54-2 to both posts.

Used steel tape and staff compass with 20°E declination, measured to the center of the bearing trees.

This corner was remonumented on July 24, 1985.

Witness: John Tuttle

Cap is marked:

MS 421
I
Cor. 2
1985 PLS 1106

**REGISTERED
PROFESSIONAL
LAND SURVEYOR**

William R. Wells

**OREGON
JULY 22, 1977
WILLIAM R. WELLS
1106**

Office of.....County Surveyor..... County of.....Baker.....
State of.....Oregon....., I hereby certify that the within instrument was filed in this office
for record on the...27... day of.....Aug....., 1985
..... by
(COUNTY OFFICIAL) (DEPUTY)