


PLAT OF MS 477 AND PART OF MS 421 LOCATED IN SECTIONS 33 & 34, T8S R36E W1M, & SECTIONS 34, T8S R36E W1M, BAKER & GRANT COUNTIES, OREGON.

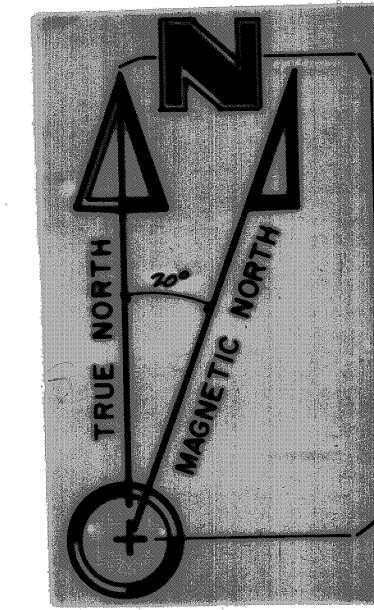

SCALE: 1"=300'
 1 METERS = 3.2808'
 BASIS OF BEARINGS: SOLAR OBSERVATION
 NEAR ALBINE CORNER 4.

LEGEND

- - SET 2 1/4" X 90" ALUM. PIPE WITH 2 1/4" ALUM. CAP, FROM EXISTING ORIGINAL EVIDENCE UNLESS OTHERWISE NOTED.
- - SET 2 1/4" X 90" ALUM. PIPE WITH 2 1/4" ALUM. CAP, BY SURVEY METHOD OF REESTABLISHMENT NOTED IN NARRATIVE.
- NATIONAL FOREST BOUNDARY - BOUNDARY POSTED.
- (X01) - MEASUREMENTS FROM ORIGINAL MINERAL SURVEY NOTES.
- EXISTING ROADS CROSSED BY TRAVERSE LINES.

HISTORY OF SURVEY

MS 477 WAS ORIGINALLY SURVEYED BY ARTHUR PHILBRICK, US DEPUTY MINERAL SURVEYOR, FOR THE BALD MOUNTAIN GOLD MINING COMPANY IN JUNE AND JULY, 1902. MS 421 WAS ORIGINALLY SURVEYED BY CHAS. M. FOSTER, US DEPUTY MINERAL SURVEYOR, FOR ARTHUR HILL, IN AUGUST, 1901.

NARRATIVE OF SURVEY


THE PURPOSE OF THIS SURVEY WAS TO RETRACE THE BOUNDARIES OF MS 477 AND A PART OF MS 421, TO RECOVER AND REMONUMENT ORIGINAL CORNERS, AND TO POST THE PRESENT NATIONAL FOREST BOUNDARY. AS INDICATED ON THE PLAT, ACCEPTABLE ORIGINAL EVIDENCE FOR ALL NUMBERED CLAIM CORNERS WAS FOUND, EXCEPT FOR ALBINE CORNER 3, WHICH HAD BEEN DESTROYED BY ROAD CONSTRUCTION. END CENTERS ON THE NATIONAL FOREST BOUNDARY WERE SEARCHED AND WERE RECOVERED IN MOST CASES. THE WHITEHALL WEST END CENTER, THREE STAR WEST END CENTER, AND THE EAST END CENTERS OF ALBINE AND SAGINAW WERE NOT RECOVERED AND WERE NOT REESTABLISHED. ALBINE CORNER 3 WAS REESTABLISHED BY SINGLE PROPORTION MEASUREMENT ALONG THE NORTH LINE OF THE THREE STAR CLAIM. OUR SURVEYS WERE MADE WITH A 1 SECOND THEODOLITE AND INFA-RED DISTANCE MEASURING EQUIPMENT.

SURVEYORS CERTIFICATION

I, WILLIAM R. WELLS, A REGISTERED PROFESSIONAL LAND SURVEYOR IN THE STATE OF OREGON, DO HEREBY CERTIFY THAT THIS PLAT AND THE NOTES HEREON OR ATTACHED, ARE A CORRECT REPRESENTATION OF A SURVEY PERFORMED BY ME DURING THE MONTHS OF AUGUST AND SEPTEMBER, 1985, AT THE REQUEST OF THE USDA, FOREST SERVICE. SAID PLAT AND NOTES WERE PREPARED IN ACCORDANCE WITH THE STATUTES OF THE STATE OF OREGON AND WITH THE ARTICLES OF THE CONTRACT.

William R. Wells
 WILLIAM R. WELLS, PLS
 OREGON LICENSE NO. 1106

REGISTERED
 PROFESSIONAL
 LAND SURVEYOR
 William R. Wells
 OREGON
 JULY 22, 1977
 WILLIAM R. WELLS
 1106

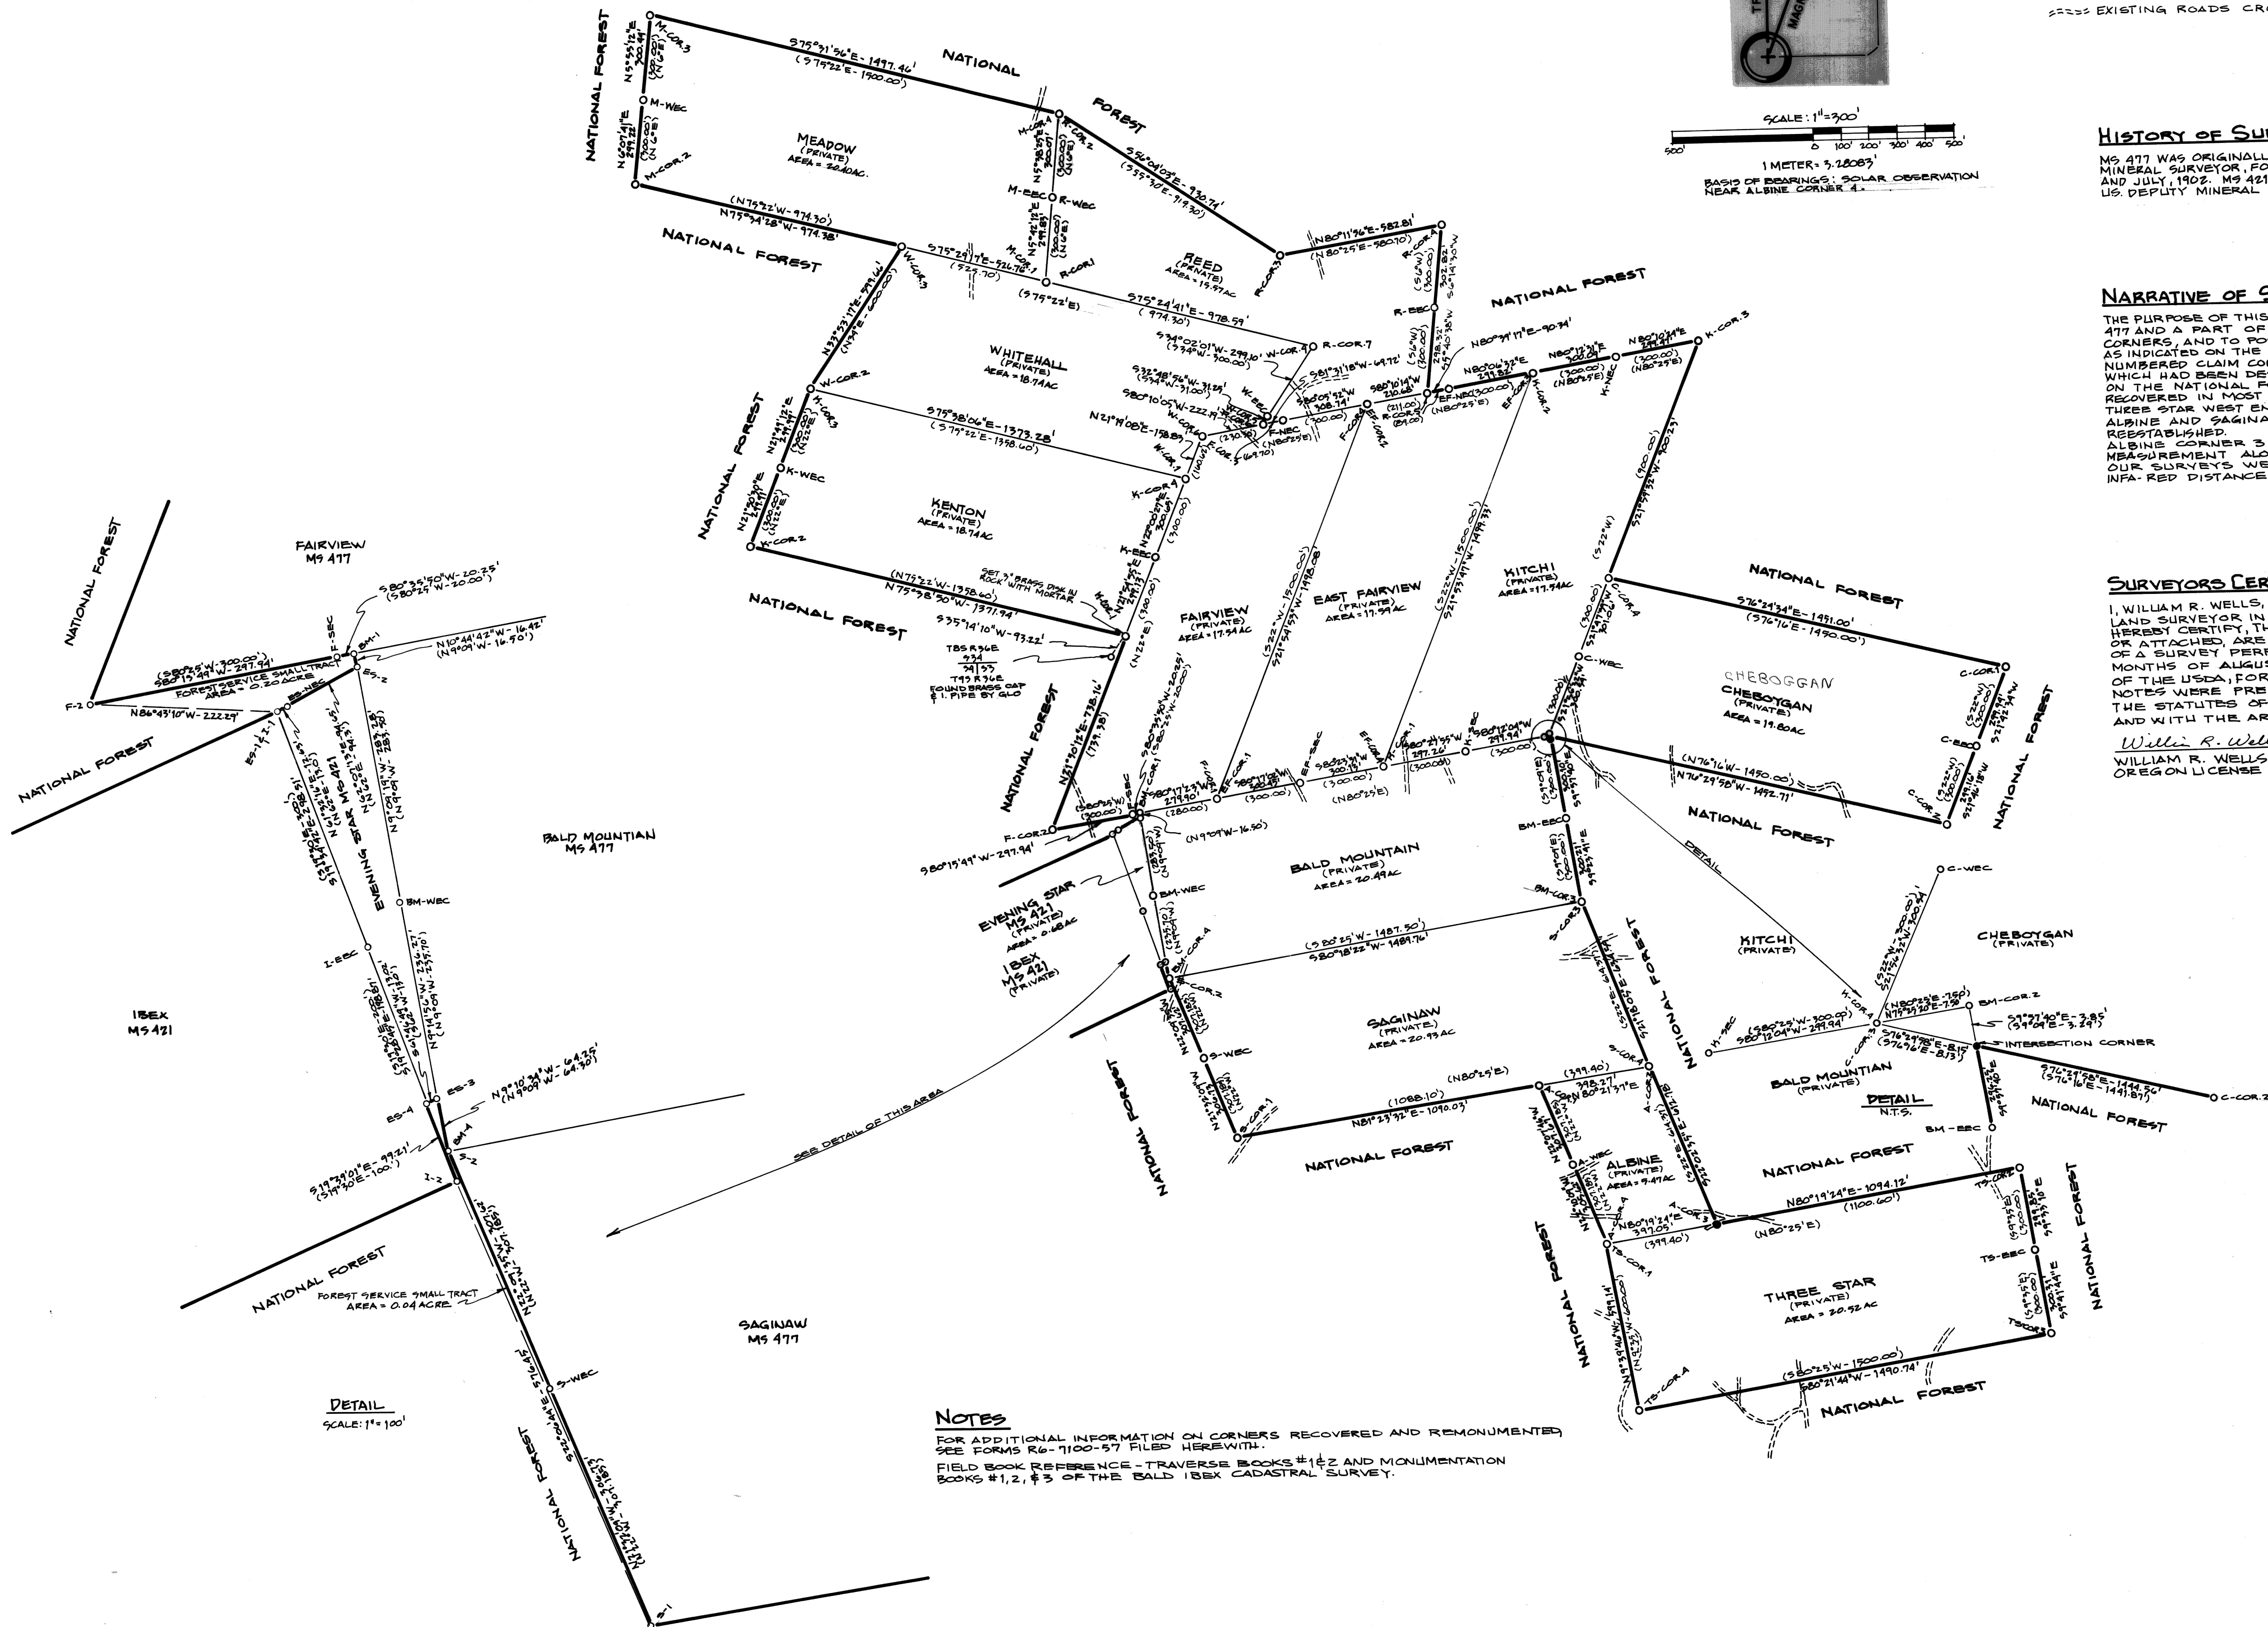

NOTES

FOR ADDITIONAL INFORMATION ON CORNERS RECOVERED AND REMONUMENTED SEE FORMS R6-1100-57 FILED HEREWITH.
 FIELD BOOK REFERENCE - TRAVERSE BOOKS #1 & 2 AND MONUMENTATION BOOKS #1, 2, & 3 OF THE BALD ISEX CADASTRAL SURVEY.

FILED Oct. 8, 1985
 BAKER COUNTY SURVEYOR
 SURV. NO. 9-36-45
 8-36-23

WILLIAM R. WELLS, PLS
 LAND SURVEYING SERVICES
 P.O. BOX 1696
 PENDLETON, OREGON 97801
 PHONE: 503 276 6362

Date: 9-13-85 Dr. By: WRW
 Ck. By: WRW No: 85-21

PROJECT:
 BALD ISEX CADASTRAL SURVEY
 PLAT OF MS 477 - MS 421

SURVEY PERFORMED FOR THE
 WALLOWA WHITMAN NATIONAL FOREST
 CONTRACT NO: 53-04H1-5-9780N