


CERTIFIED RECORD OF LAND CORNER MONUMENTATION

History of original corner establishment:

The corner was originally established by Arthur Philbrick under Mineral Survey No. 477, during the survey of June and July 1902. The original notes state that at the corner a scribed slate rock, 24" by 18" by 12", was set 12" in the ground and surrounded with a mound of earth and stone from which:

A 24" tamarack bears S59°10'W-27.33'.
An 18" black pine bears N43°10'W-26.55'.
Both marked B.T.A.4-T.S.1-477.

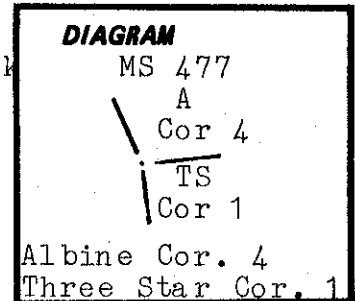

Description of corner evidence found:

Found a 24" by 12" by 5" slate stone with an "X" on the top and chisel marks on the side, protruding 10" from the ground from which:

An 18" western larch stump bears S60½°W-28.1' with catface (original bearing tree)

Description of monument and accessories I established to perpetuate the original location of this corner:

Set a 2½" by 30" aluminum pipe with a 2½" aluminum cap 10" in the ground to rock and surrounded with a mound of earth and stone. Buried original stone in mound alongside the new monument. From the monument:

A 7" engleman spruce bears S49°W-9.0' scribed 4-A-1-TS-477 BT.
A 14" engleman spruce bears N52½°W-6.1' scribed 4-A-1-TS-477 BT.
New bearing trees have a brass washer stamped PLS 1106 nailed to the face of blaze. Attached signs 54-3 and 54-9 to each bearing tree and painted face of blaze and a 6" red band around each bearing tree. Set steel fence posts on National Forest Boundary NW and SE of corner and attached sign 54-9 to one post and sign 54-2 to both posts.

Used steel tape and staff compass with 20°E declination, measured to the center of the bearing trees.

This corner was remonumented on August 14, 1985.

Witness: John Tuttle


REGISTERED
PROFESSIONAL
LAND SURVEYOR

Will: R. Wells

OREGON
JULY 22, 1977
WILLIAM R. WELLS
1106

Cap is marked:

MS 477

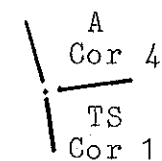

1985
PLS 1106

Office of.....County...Surveyor..... County of...Baker.....
State of.....Oregon....., I hereby certify that the within instrument was filed in this office
for record on the...2... day of.....Oct....., 1985

..... by
(COUNTY OFFICIAL) (DEPUTY)

Form R6-7100-57 (9/71)

FILED.....
BAKER COUNTY SURVEYOR
SURVEY NO. 9-36-48

☆ GPO—798-276