


CERTIFIED RECORD OF LAND CORNER MONUMENTATION

History of original corner establishment:

The corner was originally established by Arthur Philbrick under Mineral Survey No. 477, during June and July 1902. The original notes state that at the corner a scribed black pine post 4' long by 4" sq. was set 12" in the ground and surrounded with a mound of earth from which:
 A 12" red fir bears N72°40'W-6.0'.
 An 8" black pine bears S60°E-0.6'.
 Both marked B.T.A.3-477.

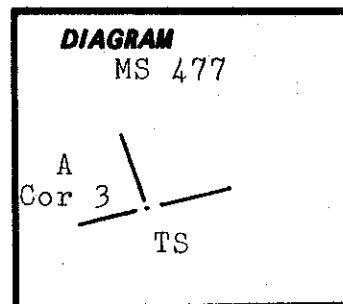

Albine Cor. 3

Description of corner evidence found:

No corner evidence was found.
 Re-established corner by single proportion measure between Three Star Corner and Three Star Corner 2. The corner area has been obliterated by road building.

Description of monument and accessories I established to perpetuate the original location of this corner:

Set a 2½" by 30" aluminum pipe with a 2½" aluminum cap 24" in the ground and surrounded with a mound of earth and stone, from which:

A 7" white fir bears S30½°E-31.1' scribed 3-A-477 BT.
 A 6" lodgepole pine bears S72½°E-50.9' scribed 3-A-477 BT.
 Two bearing trees have a brass washer stamped PLS 1106 nailed to face of blaze. Attached sign 54-3 and 54-9 to each bearing tree and painted face of blaze and 6" red band around each bearing tree. Set steel fence posts on National Forest Boundary NW and NE of corner and attached sign 54-9 to one post and sign 54-2 to both posts.

Used steel tape and staff compass with 20°E declination, measured to the center of the bearing trees.

Cap is marked:
 MS 477

This corner was remonumented on August 30, 1985.

Witness: John Tuttle

REGISTERED
 PROFESSIONAL
 LAND SURVEYOR

William R. Wells

OREGON
 JULY 22, 1977
 WILLIAM R. WELLS
 1106

A
 Cor 3
 TS

1985
 PLS 1106

Office of.....County Surveyor.....County of.....Baker.....
 State of.....Oregon....., I hereby certify that the within instrument was filed in this office
 for record on the.....~~25~~..... day of.....~~Oct~~....., 19~~85~~
 by
 (COUNTY OFFICIAL) (DEPUTY)

Form R6-7100-57 (9/71)

☆ GPO—798-276

FILED
 BAKER COUNTY SURVEYOR
 SURVEY NO. 9-36-49