


CERTIFIED RECORD OF LAND CORNER MONUMENTATION

History of original corner establishment:

This corner was originally established by Arthur Philbrick under Mineral Survey No. 477, during June and July 1902. The original notes state that at the corner a scribed black pine post 4' long by 4" sq. was set 12" in the ground and surrounded with a mound of earth.

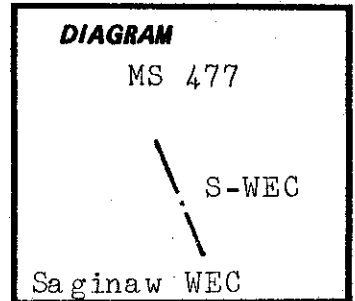

Description of corner evidence found:

A mound of earth and stone with the rotted remains of the post in a hole in the middle.

Description of monument and accessories | established to perpetuate the original location of this corner:

Set a 2½" by 30" aluminum pipe with a 2½" aluminum cap 26" in the ground and surrounded with a mound of earth and stone from which:

A 9" douglas fir bears S17½°E-26.0' scribed WEC-S-477 BT.

An 11" douglas fir bears S11°W-59.5' scribed WEC-S-477 BT.

New bearing trees have a brass washer stamped PLS 1106 nailed to face of blaze. Attached signs 54-3 and 54-9 to each bearing tree and painted face of blaze and a 6" red band around each bearing tree. Set steel fence posts on National Forest Boundary NW and SE of corner and attached sign 54-9 to one post and sign 54-2 to both posts.

Used steel tape and staff compass with 20°E declination, measured to the center of the bearing trees.

Cap is marked:


MS 477

S-WEC


1985
PLS 1106

This corner was remonumented on August 29, 1985.

Witness: John Tuttle

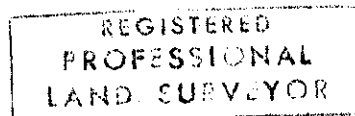

William R. Wells

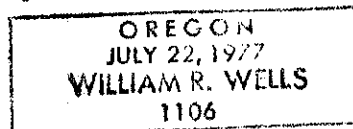

Office of.....County...Surveyor..... County of.....Baker.....
State of.....Oregon....., I hereby certify that the within instrument was filed in this office
for record on the...8... day of.....Oct....., 1985

..... by
(COUNTY OFFICIAL) (DEPUTY)

Form R6-7100-57 (9/71)

☆ U.S. GOVERNMENT PRINTING OFFICE - 1983-793-276

FILED
SURVEY NO. 9-36-53