


CERTIFIED RECORD OF LAND CORNER MONUMENTATION

History of original corner establishment:

The corner was originally established by Arthur Philbrick under Mineral Survey No. 477, during the survey of June and July 1902. The original notes state that at the corner a scribed fir post 4' long by 4" sq. was set 12" in the ground and surrounded with a mound of earth and stone from which:

A 30" red fir bears S19°45'E-11.62'.
A 12" tamarack bears N82°56'E-23.35'.
Both marked B.T.T.S.4-477.

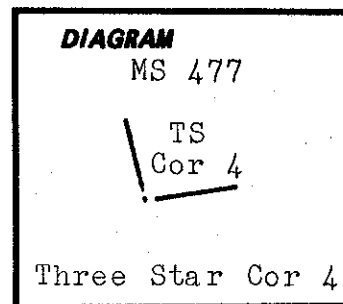

Description of corner evidence found:

Found a mound of earth and stone and the remains of the post at the ground level from which:

A 36" white fir bears S19°45'-11.6' to face of blaze and 13.0' to claim line with healed blaze (original bearing tree).
A 14" down western larch bears N83°E-23'± with no scribing visible (original bearing tree).

Description of monument and accessories I established to perpetuate the original location of this corner:

Set a 2½" by 30" aluminum pipe with a 2½" aluminum cap 24" in the ground and surrounded with a mound of earth and stone from which:

A 10" white fir bears N19½°E-29.1' scribed 4-TS-477 BT.
A 6" white fir bears N23½°E-83.7' scribed 4-TS-477 BT.
An 8" white fir bears N84½°W-20.9' scribed 4-TS-477 BT.
New bearing trees have a brass washer stamped PLS 1106 nailed to face of blaze. Attached sign 54-3 and 54-9 to each bearing tree and painted face of blaze and a 6" red band around each bearing tree. Set steel fence posts on National Forest Boundary NW and NE of corner and attached sign 54-9 to one post and sign 54-2 to both posts.

Cap is marked:

Used steel tape and staff compass with 20°E declination, measured to the center of the bearing trees.

This corner was remonumented on August 14, 1985.

Witness: John Tuttle

REGISTERED
PROFESSIONAL
LAND SURVEYOR

William R. Wells

OREGON
JULY 22, 1977
WILLIAM R. WELLS
1106

MS 477

1985
PLS 1106

Office of County Surveyor..... County of Baker.....
State of Oregon..... I hereby certify that the within instrument was filed in this office
for record on the 8 day of Oct., 1985

..... by
(COUNTY OFFICIAL) (DEPUTY)

Form R6-7100-57 (9/71)

☆ GPO-798-276

FILED.....
BAKER COUNTY SURVEYOR
SURVEY NO. 9-36-56