


CERTIFIED RECORD OF LAND CORNER MONUMENTATION

History of original corner establishment:

This corner was originally established by Arthur Philbrick under Mineral Survey No. 477, during the survey of June and July 1902. The original notes state that at the corner a scribed black pine post 4' long by 4" sq. was set 12" in the ground and surrounded with a mound of earth from which:

An 8" black pine bears S68°W-17'.
A 14" tamarack bears N58°W-25.67'.
Both marked B.T.T.S.E.C.-477.

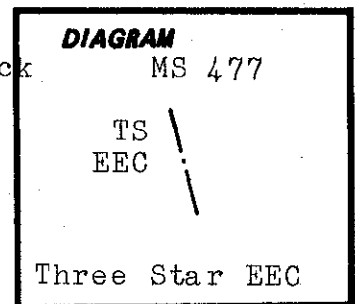

Description of corner evidence found:

Found the rotted remains of the post at ground level from which:

A 12" lodgepole pine stump bears S68°W-17.5'± with visible scribing (original bearing tree).
A 12" western larch stump (rotten) bears N58°W-26'± with no scribing (original bearing tree). This tree was too rotten to attach signs.

Description of monument and accessories I established to perpetuate the original location of this corner:

Set a 2½" by 30" aluminum pipe with a 2½" aluminum cap 20" in the ground and surrounded with a mound of earth and stone from which:

A 6" white fir bears S62½°E-11.1' scribed EEC-TS-477 BT.
An 8" white fir bears N65°E-15.6' scribed EEC-TS-477 BT.
New bearing trees have a brass washer stamped PLS 1106 nailed to the face of blaze. Attached signs 54-3 and 54-9 to each bearing tree and painted face of blaze and a 6" red band around each bearing tree. Set steel fence posts on National Forest Boundary NW and SE of corner and attached sign 54-9 to one post and sign 54-2 to both posts.

Used steel tape and staff compass with 20°E declination, measured to the center of the bearing trees.

This corner was remonumented on August 14, 1985.

Witness: John Tuttle

REGISTERED
PROFESSIONAL
LAND SURVEYOR

William R. Wells

OREGON
JULY 22, 1977
WILLIAM R. WELLS
1106

Cap is marked:

MS 477

TS
EEC

1985
PLS 1106

Office of.....County Surveyor..... County of.....Baker.....
State of.....Oregon....., I hereby certify that the within instrument was filed in this office
for record on the...2... day of.....Oct....., 1985

..... by
(COUNTY OFFICIAL) (DEPUTY)