


CERTIFIED RECORD OF LAND CORNER MONUMENTATION

History of original corner establishment:

The corner was originally established by Arthur Philbrick under Mineral Survey No. 477, during the survey of June and July 1902. The original notes state that at the corner a scribed black pine post 4' long by 4" sq. was set 12" in the ground and surrounded with a mound of earth from which:

A 36" tamarack bears N43°40'E-8.74'.
A 12" tamarack bears S80°10'W-35.31'.
Both marked B.T.T.S.2-477.

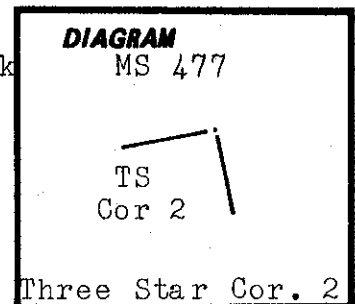

Description of corner evidence found:

Found the rotted remains of the post at ground level from which:

A 44" down white fir bears N44°E-9'± with scribing visible on open blaze (original bearing tree).
A 13" standing western larch snag bears S80½°W-35.8' with scribing visible on opened blaze (original bearing tree).

Description of monument and accessories | established to perpetuate the original location of this corner:

Set a 2½" by 30" aluminum pipe with a 2½" aluminum cap 24" in the ground and surrounded with a mound of earth and stone from which:

An 8" lodgepole pine bears N62½°E-20.5' scribed 2-TS-477 BT.
A 6" white fir bears S40°E-19.9' scribed 2-TS-477 BT.
New bearing trees have a brass washer stamped PLS 1106 nailed to face of blaze. Attached signs 54-3 and 54-9 to each bearing tree and painted face of blaze and a 6" red band around each bearing tree. Set steel fence posts on National Forest Boundary SW and SE of corner and attached sign 54-9 to one post and sign 54-2 to both posts.

Cap is marked:

Used steel tape and staff compass with 20°E declination, measured to the center of the bearing trees.

This corner was remonumented on August 14, 1985.

Witness: John Tuttle

REGISTERED
PROFESSIONAL
LAND SURVEYOR

William R. Wells

OREGON
JULY 22, 1977
WILLIAM R. WELLS
1106

MS 477

TS
Cor 2

1985
PLS 1106

Office of.....County Surveyor.....County of.....Baker.....
State of.....Oregon....., I hereby certify that the within instrument was filed in this office
for record on the...8... day of.....Oct....., 1985
..... by
(COUNTY OFFICIAL) (DEPUTY)

Form R6-7100-57 (9/71)

☆ GPO—790-276

FILED.....
BAKER COUNTY SURVEYOR
SURVEY NO. 2-36-58