


CERTIFIED RECORD OF LAND CORNER MONUMENTATION

History of original corner establishment:

The corner was originally established by Arthur Philbrick under Mineral Survey No. 477, during the survey of June and July 1902. The original notes state that at the corner a scribed black pine post 4' long by 4" sq. was set 12" in the ground and surrounded with a mound of earth from which:

- A 26" red fir bears N37°24'E-6.38'.
- A 24" tamarack bears S74°52'W-62.65.
- A 30" red fir bears S23°26'E-9.52'.
- All marked B.T.T.S.3-477.

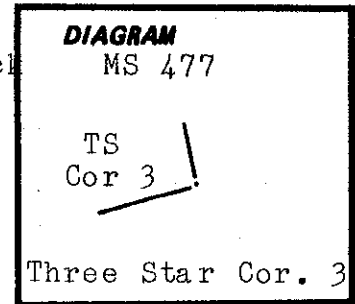

Description of corner evidence found:

Found a mound of earth with remains of the post in the middle at ground level from which:

- A root hole bears N37½°E-7'±.

Description of monument and accessories I established to perpetuate the original location of this corner:

Set a 2½" by 30" aluminum pipe with a 2½" aluminum cap 24" in the ground and surrounded with a mound of earth and stone. Placed the remains of the original post on the mound. From the new monument:

- A 13" white fir bears N66½°E-17.8' scribed 3-TS-477 BT.
- A 10" white fir bears S54½°E-39.8' scribed 3-TS-477 BT.
- New bearing trees have brass washer stamped PLS 1106 nailed to face of blaze.
- Attached signs 54-3 and 54-9 to each bearing tree and painted face of blaze and a 6" red band around each bearing tree. Set steel fence posts on National Forest Boundary SW and NW of corner and attached sign 54-9 to one post and sign 54-2 to both posts.

Cap is marked:

Used steel tape and staff compass with 20°E declination, measured to the center of the bearing trees.

This corner was remonumented on August 14, 1985.

Witness: John Tuttle

REGISTERED
PROFESSIONAL
LAND SURVEYOR

William R. Wells

OREGON
JULY 22, 1977
WILLIAM R. WELLS
1106

MS 477
TS
Cor 3
1985
PLS 1106

Office of.....County.....Surveyor..... County of.....Baker.....
State of.....Oregon....., I hereby certify that the within instrument was filed in this office
for record on the...8... day of.....Oct....., 1985

..... by
(COUNTY OFFICIAL) (DEPUTY)