


CERTIFIED RECORD OF LAND CORNER MONUMENTATION

History of original corner establishment:

This corner was originally established by Arthur Philbrick under Mineral Survey No. 477, during June and July 1902. The original notes state that at the corner a scribed tamarack post 4' long by 4" sq. was set 12" in the ground and surrounded with a mound of earth from which:

A 4' red fir bears N19°10'E-22.45'.
A 12" pine bears N61°20'W-2.04'.
Both marked B.T.C.1-477.

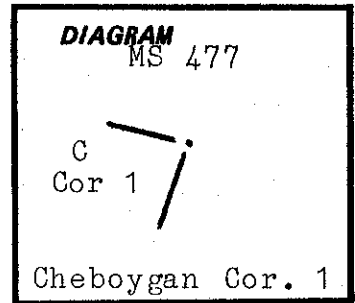

Description of corner evidence found:

A mound of earth and the remains of the rotted post at ground level from which:

A 13" dead, down lodgepole pine bears N61°W-2.5' to root hole with visible scribing on open blaze (original bearing tree).
A 48" white fir bears N24°E-24.0' with visible scribing on partly healed blaze (original bearing tree).

Description of monument and accessories established to perpetuate the original location of this corner:

Set a 2½" by 30" aluminum pipe with a 2½" aluminum cap 18" in the ground and surrounded with a mound of earth and stone from which:

A 10" white fir bears S59½°E-39.7' scribed 1-C-477 BT.
New bearing tree has a brass washer stamped PLS 1106 nailed to face of blaze. Attached signs 54-3 and 54-9 to each bearing tree and painted face of blaze and a 6" red band around each bearing tree. Set steel fence posts on National Forest Boundary NW and SW of corner and attached sign 54-9 to one post and sign 54-2 to both posts.

Cap is marked:

MS 477

Used steel tape and staff compass with 20°E declination, measured to the center of the bearing trees.

This corner was remonumented on August 28, 1985.

Witness: John Tuttle

C
Cor 1

1985
PLS 1106

REGISTERED
PROFESSIONAL
LAND SURVEYOR

William R. Wells

OREGON
JULY 22, 1977
WILLIAM R. WELLS
1106

Office of...County Surveyor..... County of...Baker.....
State of...Oregon....., I hereby certify that the within instrument was filed in this office
for record on the...28... day of...Oct... , 1985
..... by
(COUNTY OFFICIAL) (DEPUTY)

FILED
BANK COUNTY SURVEYOR
SURVEY NO. 9-36-62
8-36-