


CERTIFIED RECORD OF LAND CORNER MONUMENTATION

History of original corner establishment:

This corner was originally established by Arthur Philbrick under Mineral Survey No. 477, during June and July 1902. The original notes state that at the corner a scribed tamarack post 4' long by 4" sq. was set 12" in the ground and surrounded with amound of earth and stone from which:
An 8" black pine bears S17°21'W-8.05'.
A 12" black pine bears N85°W-1.05'.
Both marked B.T.C.W.C.-477.

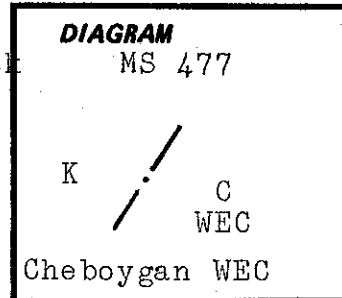

Description of corner evidence found:

Found the rotted remains of the original post at ground level from which:

A rotten lodgepole pine stump bears N85°W-1.5' with scribing visible on a piece of wood beside stump (original bearing tree).
Rotten remains of a lodgepole pine with axe marks bear S17½°W-8'±. Too rotten to attach signs. (original bearing tree).

Description of monument and accessories I established to perpetuate the original location of this corner:

Set a 2½" by 30" aluminum pipe with a 2½" aluminum cap 24" in the ground and surrounded with a mound of earth and stone from which:

A 10" alpine fir bears S57½°E-10.1' scribed WEC-C-477 BT.
An 11" white fir bears S15½°W-13.6' scribed WEC-C-477 BT.
New bearing trees have a brass washer stamped PLS 1106 nailed to face of blaze. Attached signs 54-3 and 54-9 to each bearing tree and painted face of blaze and a 6" red band around each bearing tree. Set steel fence posts on claim line near corner and attached sign 54-9.

Used steel tape and staff compass with 20°E declination, measured to the center of the bearing trees.

This corner was remonumented on August 28, 1985.

Witness: John Tuttle

Cap is marked:

MS 477

1985
PLS 1106

REGISTERED
PROFESSIONAL
LAND SURVEYOR

William R. Wells

OREGON
JULY 22, 1977
WILLIAM R. WELLS
1106

Office of.....County Surveyor.....County of.....Baker.....
State of.....Oregon....., I hereby certify that the within instrument was filed in this office
for record on the...28... day of.....Oct....., 1985
..... by
(COUNTY OFFICIAL) (DEPUTY)