

**CERTIFIED RECORD OF LAND CORNER MONUMENTATION**


**History of original corner establishment:**

This corner was originally established by Arthur Philbrick under Mineral Survey No. 477, during the survey of June and July 1902. The original notes state that at the corner a scribed black pine post 4' long by 4" sq. was set 12" in the ground and surrounded with a mound of earth from which:

A 6" pine bears S61°30'W-10.13'.

A 6" pine bears S60°E-22.14'.

Both marked B.T.F.4-E.F.2-477.

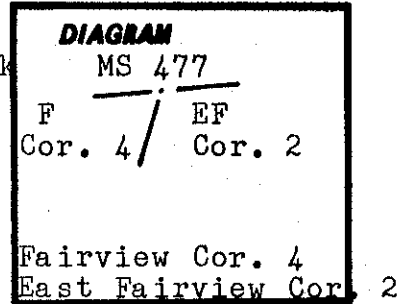

**Description of corner evidence found:**

Found a mound of earth and the rotted remains of the post at ground level from which:

An 8" dead standing lodgepole pine bears S60°E-22.2' with scribing visible on open blaze (original bearing tree).

**Description of monument and accessories established to perpetuate the original location of this corner:**

Set a 2½" by 30" aluminum pipe with a 2½" aluminum cap 24" in the ground and surrounded with a mound of earth and stone from which:

A 10" alpine fir bears N46½°E-39.3' scribed 4-F-2-EF-477 BT.

A 9" western larch bears N14½°W-34.2' scribed 4-F-2-EF-477 BT.

New bearing trees have a brass washer stamped PLS 1106 nailed to face of blaze. Attached sign 54-3 and 54-9 to each bearing tree and painted face of blaze and a 6" red band around each bearing tree. Set steel fence post on claim line near corner and attached sign 54-9.

Used steel tape and staff compass with 20°E declination, measured to the center of the bearing trees.

Cap is marked:  
MS 477  
F — EF  
Cor 4 / Cor 2

This corner was remonumented on August 28, 1985.

Witness: John Tuttle

1985  
PLS 1106

REGISTERED  
PROFESSIONAL  
LAND SURVEYOR

*William R. Wells*

OREGON  
JULY 22, 1977  
WILLIAM R. WELLS  
1106

Office of.....County Surveyor.....County of.....Baker.....  
State of.....Oregon....., I hereby certify that the within instrument was filed in this office  
for record on the...8... day of.....Oct....., 1985  
..... by .....  
(COUNTY OFFICIAL) (DEPUTY)

Form R6-7100-57 (9/71)

☆ GPO—798-878

FILED.....  
BAKER COUNTY SURVEYOR  
SURVEY NO. 9-36-69  
8-36-