
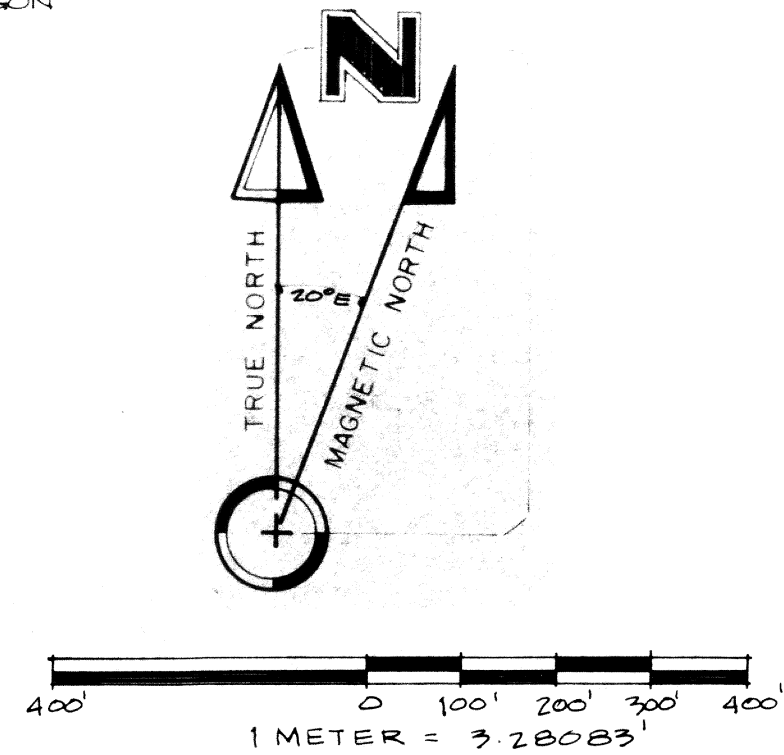


PLAT OF DEVIL'S DREAM AND MAIDEN'S DREAM - MS 599
LOCATED IN SECTIONS 10, 15, & 16, T9S R36E, WM, BAKER AND GRANT CO, OREGON

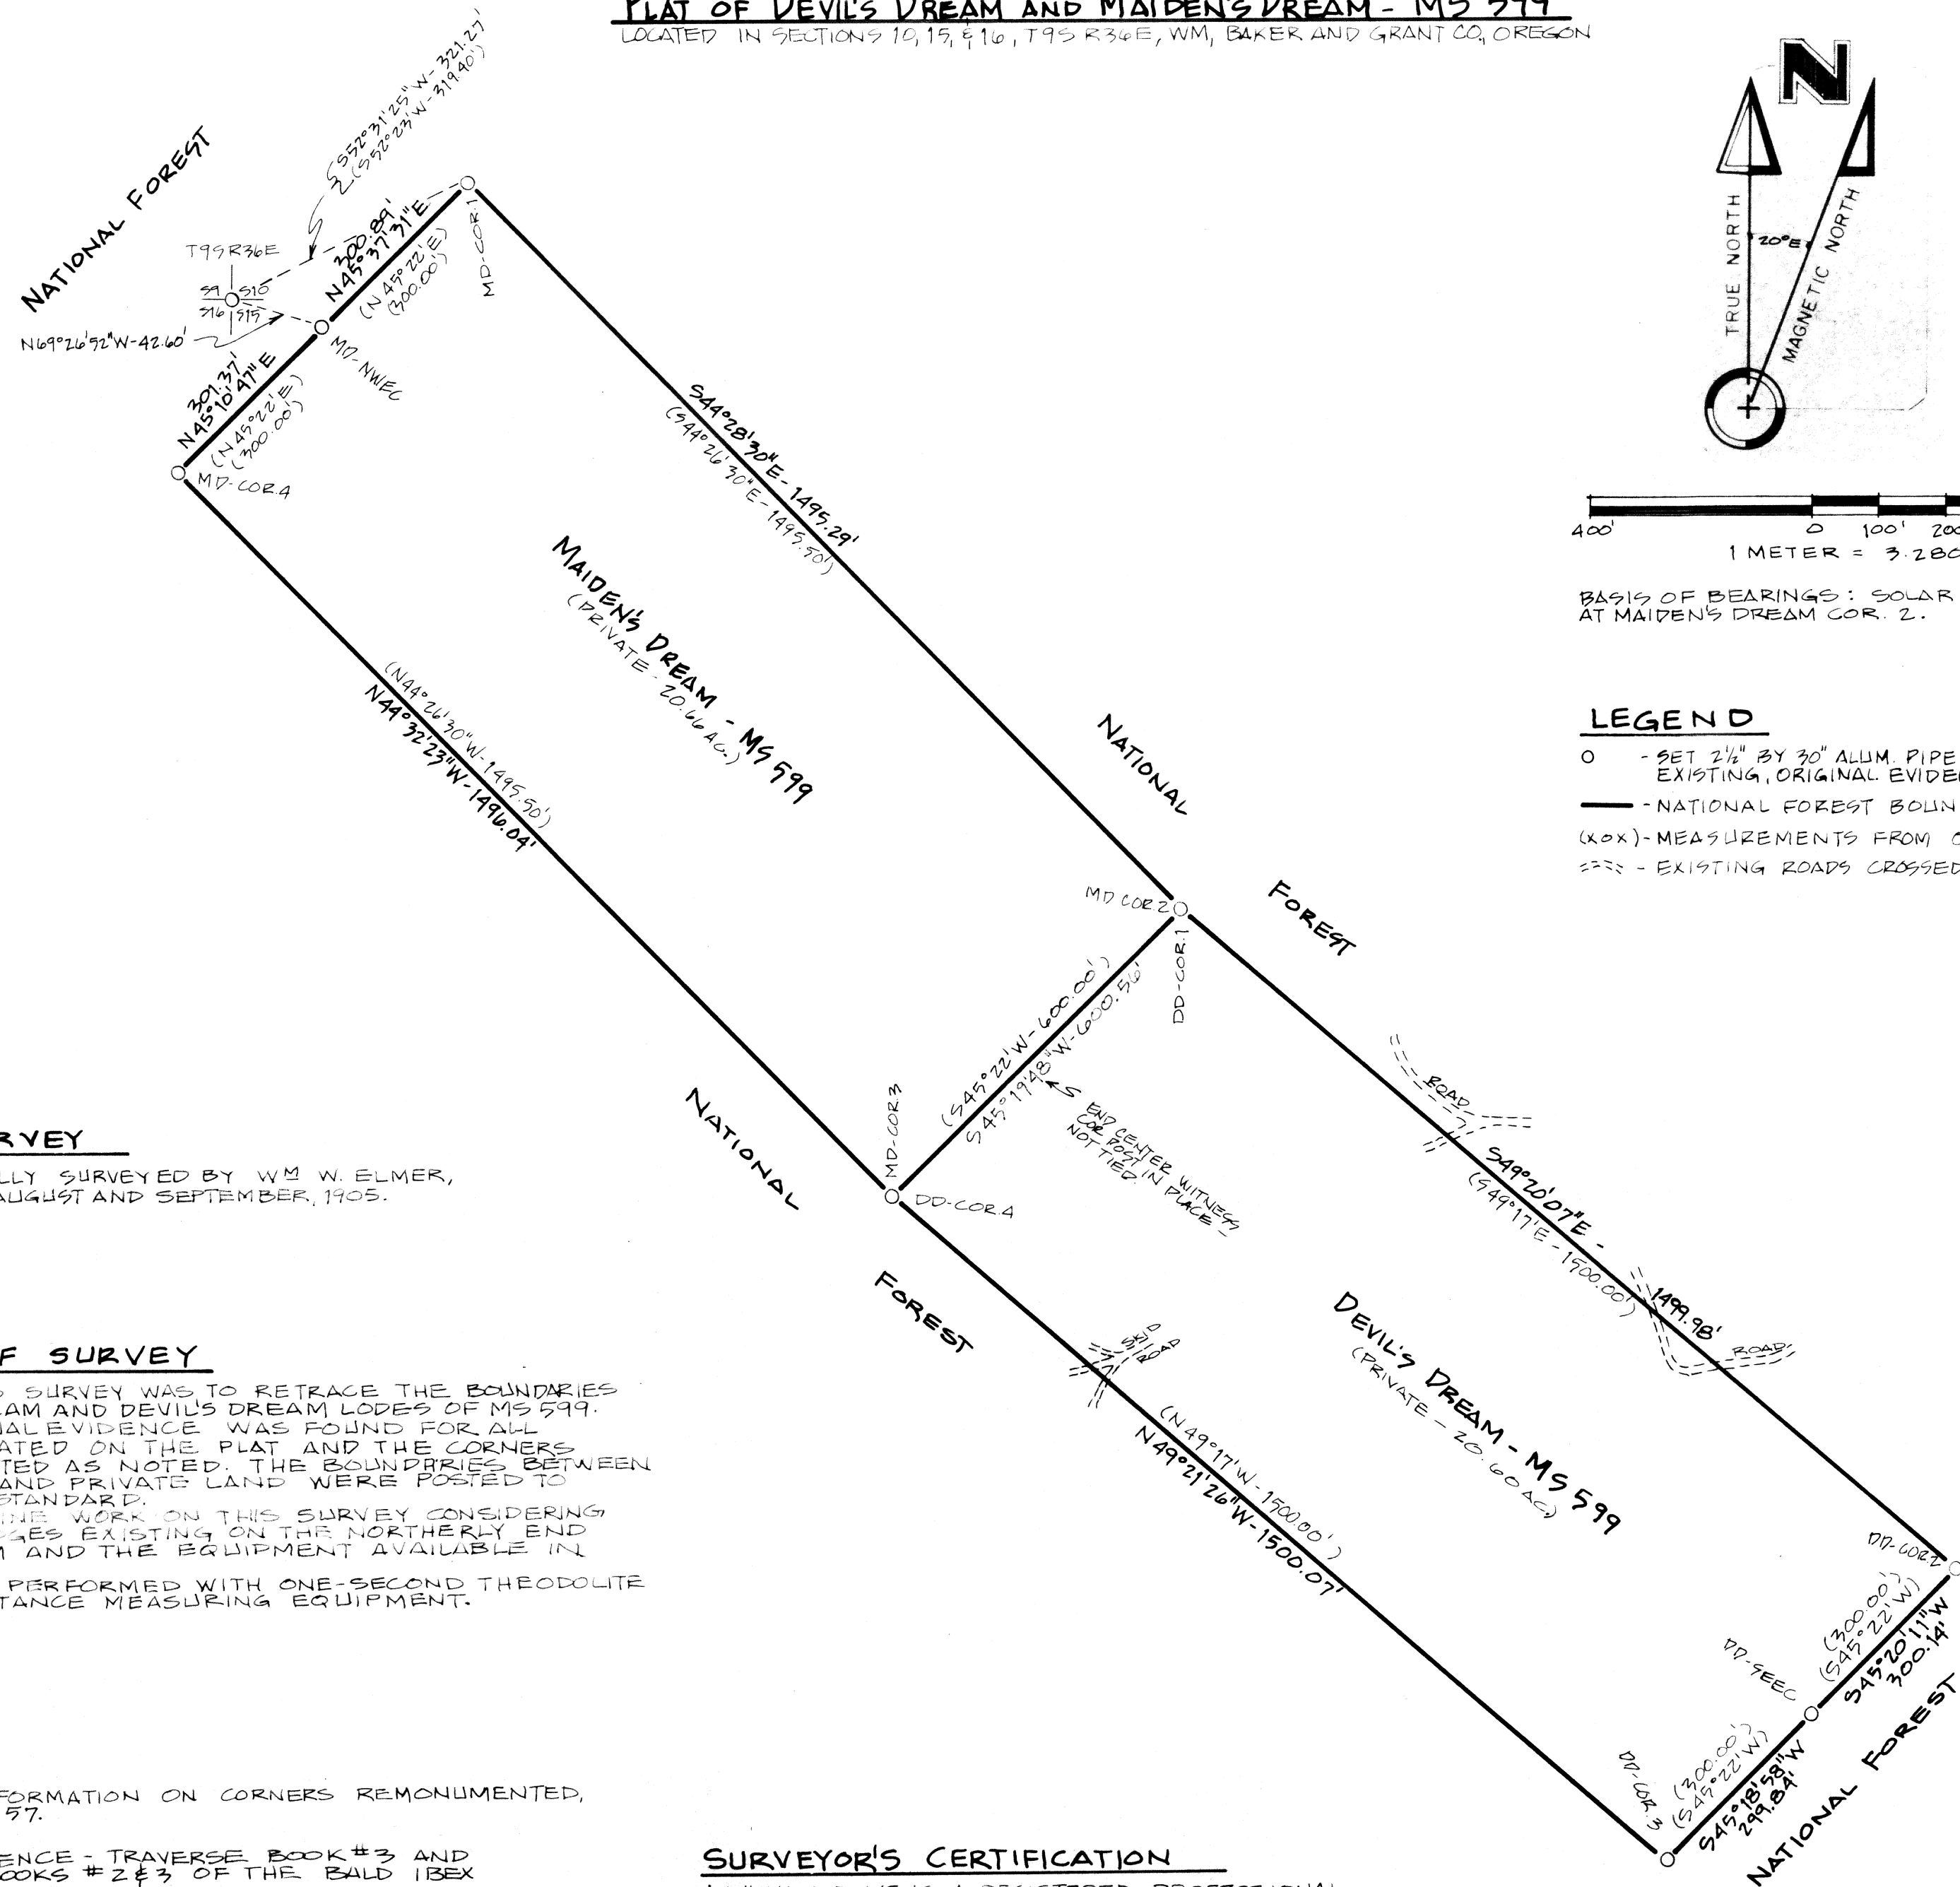

BASIS OF BEARINGS: SOLAR OBSERVATION
AT MAIDEN'S DREAM COR. 2.

LEGEND

- - SET 2 1/2" BY 30" ALUM. PIPE WITH 2 1/2" ALUM. CAP FROM EXISTING, ORIGINAL EVIDENCE.
- - NATIONAL FOREST BOUNDARY - BOUNDARY POSTED.
- (xox) - MEASUREMENTS FROM ORIGINAL MINERAL SURVEY NOTES.
- - EXISTING ROADS CROSSED BY TRAVERSE LINES.

HISTORY OF SURVEY

MS 599 WAS ORIGINALLY SURVEYED BY WM W. ELMER, FOR C.J. JOHNS, IN AUGUST AND SEPTEMBER, 1905.

NARRATIVE OF SURVEY

THE PURPOSE OF THIS SURVEY WAS TO RETRACE THE BOUNDARIES OF THE MAIDEN'S DREAM AND DEVIL'S DREAM LOTS OF MS 599. ACCEPTABLE ORIGINAL EVIDENCE WAS FOUND FOR ALL CORNERS AS INDICATED ON THE PLAT AND THE CORNERS WERE REMONUMENTED AS NOTED. THE BOUNDARIES BETWEEN NATIONAL FOREST AND PRIVATE LAND WERE POSTED TO FOREST SERVICE STANDARD. WM ELMER DID THIS WORK ON THIS SURVEY CONSIDERING THE CLIFFS AND RIDGES EXISTING ON THE NORTHERLY END OF MAIDEN'S DREAM AND THE EQUIPMENT AVAILABLE IN 1905. OUR SURVEY WAS PERFORMED WITH ONE-SECOND THEODOLITE AND INFA-RED DISTANCE MEASURING EQUIPMENT.

NOTES

FOR ADDITIONAL INFORMATION ON CORNERS REMONUMENTED, SEE FORMS RG-7100-57.

FIELD BOOK REFERENCE - TRAVERSE BOOK #3 AND MONUMENTATION BOOKS #2 & 3 OF THE BALD IBEX CADASTRAL SURVEY.

SURVEYOR'S CERTIFICATION

I, WILLIAM R. WELLS, A REGISTERED PROFESSIONAL LAND SURVEYOR IN THE STATE OF OREGON, DO HEREBY CERTIFY, THAT THIS PLAT, AND THE NOTES HEREON, OR ATTACHED, ARE A CORRECT REPRESENTATION OF A SURVEY PERFORMED BY ME DURING THE MONTH OF SEPTEMBER, 1985, AT THE REQUEST OF THE USDA, FOREST SERVICE. SAID PLAT AND NOTES WERE PREPARED IN ACCORDANCE WITH THE STATUTES OF THE STATE OF OREGON AND WITH THE ARTICLES OF THE CONTRACT.

William R. Wells

WILLIAM R. WELLS, PLS
OREGON LICENSE NO. 1106.

REGISTERED
PROFESSIONAL
LAND SURVEYOR

William R. Wells

OREGON
JULY 22, 1977
WILLIAM R. WELLS
1106

WILLIAM R. WELLS, PLS
LAND SURVEYING SERVICES
P.O. BOX 1696
PENDLETON, OREGON 97801
PHONE: 503 276 6362

PROJECT:
BALD IBEX CADASTRAL SURVEY
PLAT OF MS 599

SURVEY PERFORMED FOR THE
WALLOWA WHITMAN NAT. FOREST

CONTRACT NO. 53-0441-7-9700N

Date: 10-27-85 Dr. By: WRW
Ck. By: WRW No: 85-21

FILED 12-31-85
BAKER COUNTY SURVEYOR
SURVEY NO. 9-36-71