
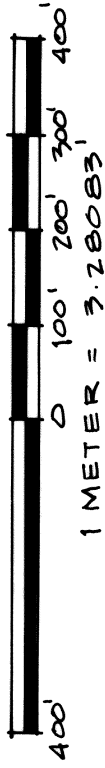



PLAT OF DEVIL'S DREAM AND MAIDEN'S DREAM - MS 599
LOCATED IN SECTIONS 10, 15, & 16, T9S R36E, WM, BAKER AND GRANT CO, OREGON

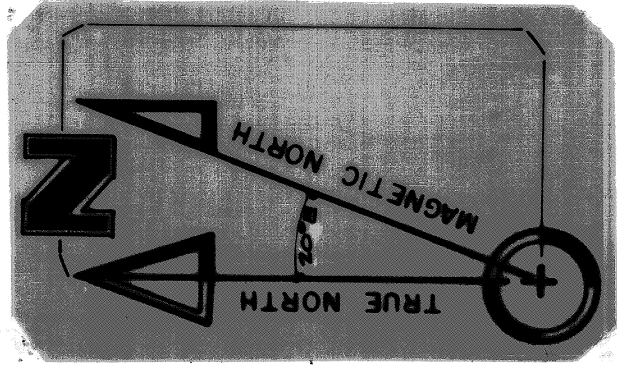

BASIS OF BEARINGS: SOLAR OBSERVATION
AT MAIDEN'S DREAM COR. 2.

LEGEND

- 0 - SET 2 1/4" BY 30" ALUM. PIPE WITH 2 1/2" ALUM CAP FROM EXISTING, ORIGINAL EVIDENCE.
- NATIONAL FOREST BOUNDARY - BOUNDARY POSTED.
- (XOX) - MEASUREMENTS FROM ORIGINAL MINERAL SURVEY NOTES.
- - - EXISTING ROADS CROSSED BY TRAVERSE LINES.

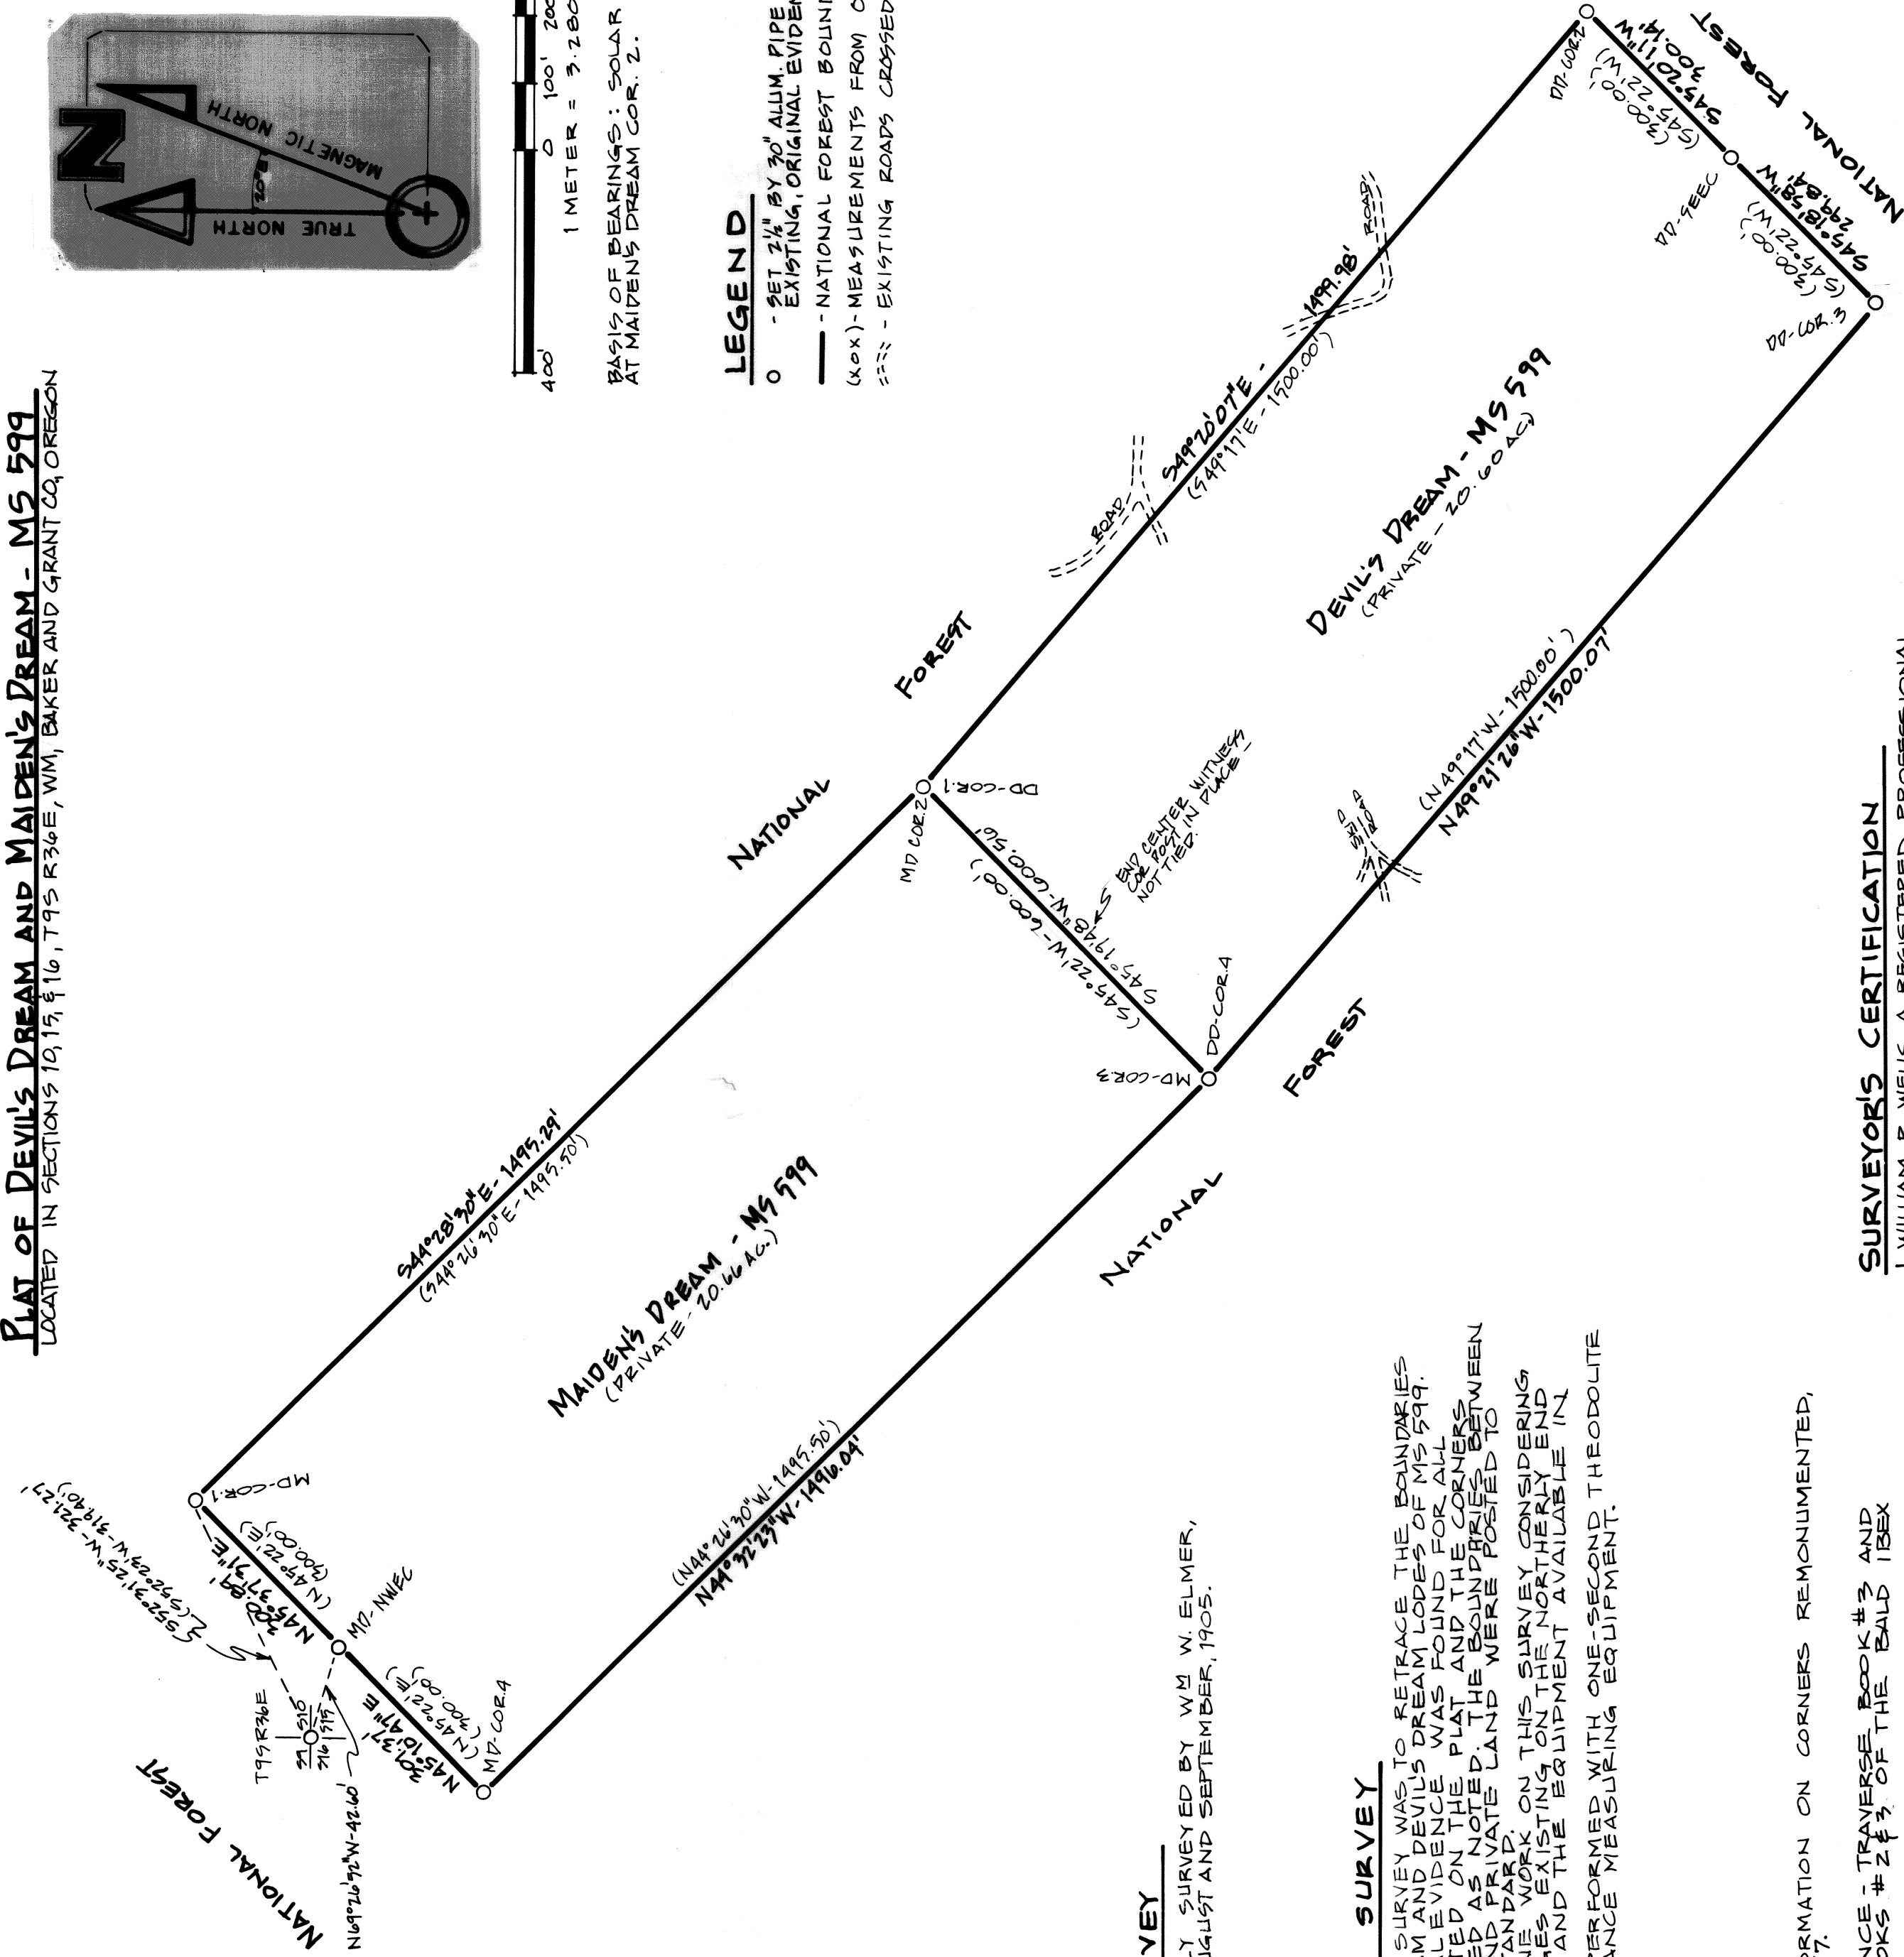

HISTORY OF SURVEY

MS 599 WAS ORIGINALLY SURVEYED BY WM W. ELMER, FOR C.J. JOHNS, IN AUGUST AND SEPTEMBER, 1905.

NARRATIVE OF SURVEY

THE PURPOSE OF THIS SURVEY WAS TO RETRACE THE BOUNDARIES OF THE MAIDEN'S DREAM AND DEVIL'S DREAM LODES OF MS 599. ACCEPTABLE ORIGINAL EVIDENCE WAS FOUND FOR ALL CORNERS AS INDICATED ON THE PLAT AND THE CORNERS WERE REMONUMENTED AS NOTED. THE BOUNDARIES BETWEEN NATIONAL FOREST AND PRIVATE LAND WERE POSTED TO FOREST SERVICE STANDARD. WM ELMER DID FINE WORK ON THIS SURVEY CONSIDERING THE CLIFFS AND RIDGES EXISTING ON THE NORTHERLY END OF MAIDEN'S DREAM AND THE EQUIPMENT AVAILABLE IN 1905. OUR SURVEY WAS PERFORMED WITH ONE-SECOND THEODOLITE AND INFRA-RED DISTANCE MEASURING EQUIPMENT.

NOTES

FOR ADDITIONAL INFORMATION ON CORNERS REMONUMENTED, SEE FORMS RG-7100-57.

FIELD BOOK REFERENCE - TRAVERSE BOOK #3 AND MONUMENTATION BOOKS # 2 & 3 OF THE BALD IBEX CADASTRAL SURVEY.

REGISTERED
PROFESSIONAL
LAND SURVEYOR

Willie R. Wells

OREGON
JULY 22, 1977
WILLIAM R. WELLS
1106

WILLIAM R. WELLS, PLS
LAND SURVEYING SERVICES
P.O. BOX 1696
PENDLETON, OREGON 97801
PHONE: 503 276 6362

Date: 10-27-85
Dr. By: WRW

Ck. By: WRW
No: 85-21

PROJECT:

BALD IBEX CADASTRAL SURVEY
PLAT OF MS 599

SURVEY PERFORMED FOR THE
WALLOWA WHITMAN NAT. FOREST

CONTRACT NO. 93-04H1-7-9780N

FILED 12-31-85

BAKER COUNTY SURVEYOR

SURVEY NO. 9-36-71