



PLAT OF MS 421, 744 AND PART OF MS 477
LOCATED IN SECTIONS 3&4 T9S R30E, W1N,
GRANT & BAKER COUNTIES, OREGON

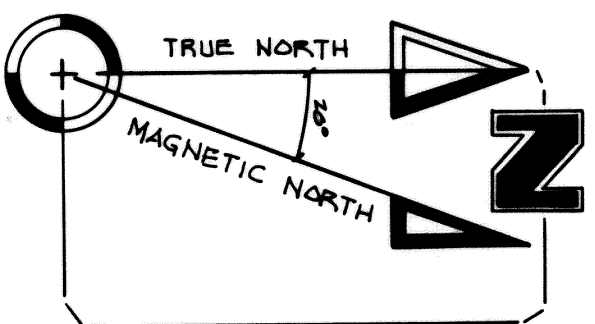

SCALE: 1"=300'

1 METER = 3.28084'

BASE OF BEARING: SOLAR OBSERVATION
NEAR ALBINE CORNER, MS 477.

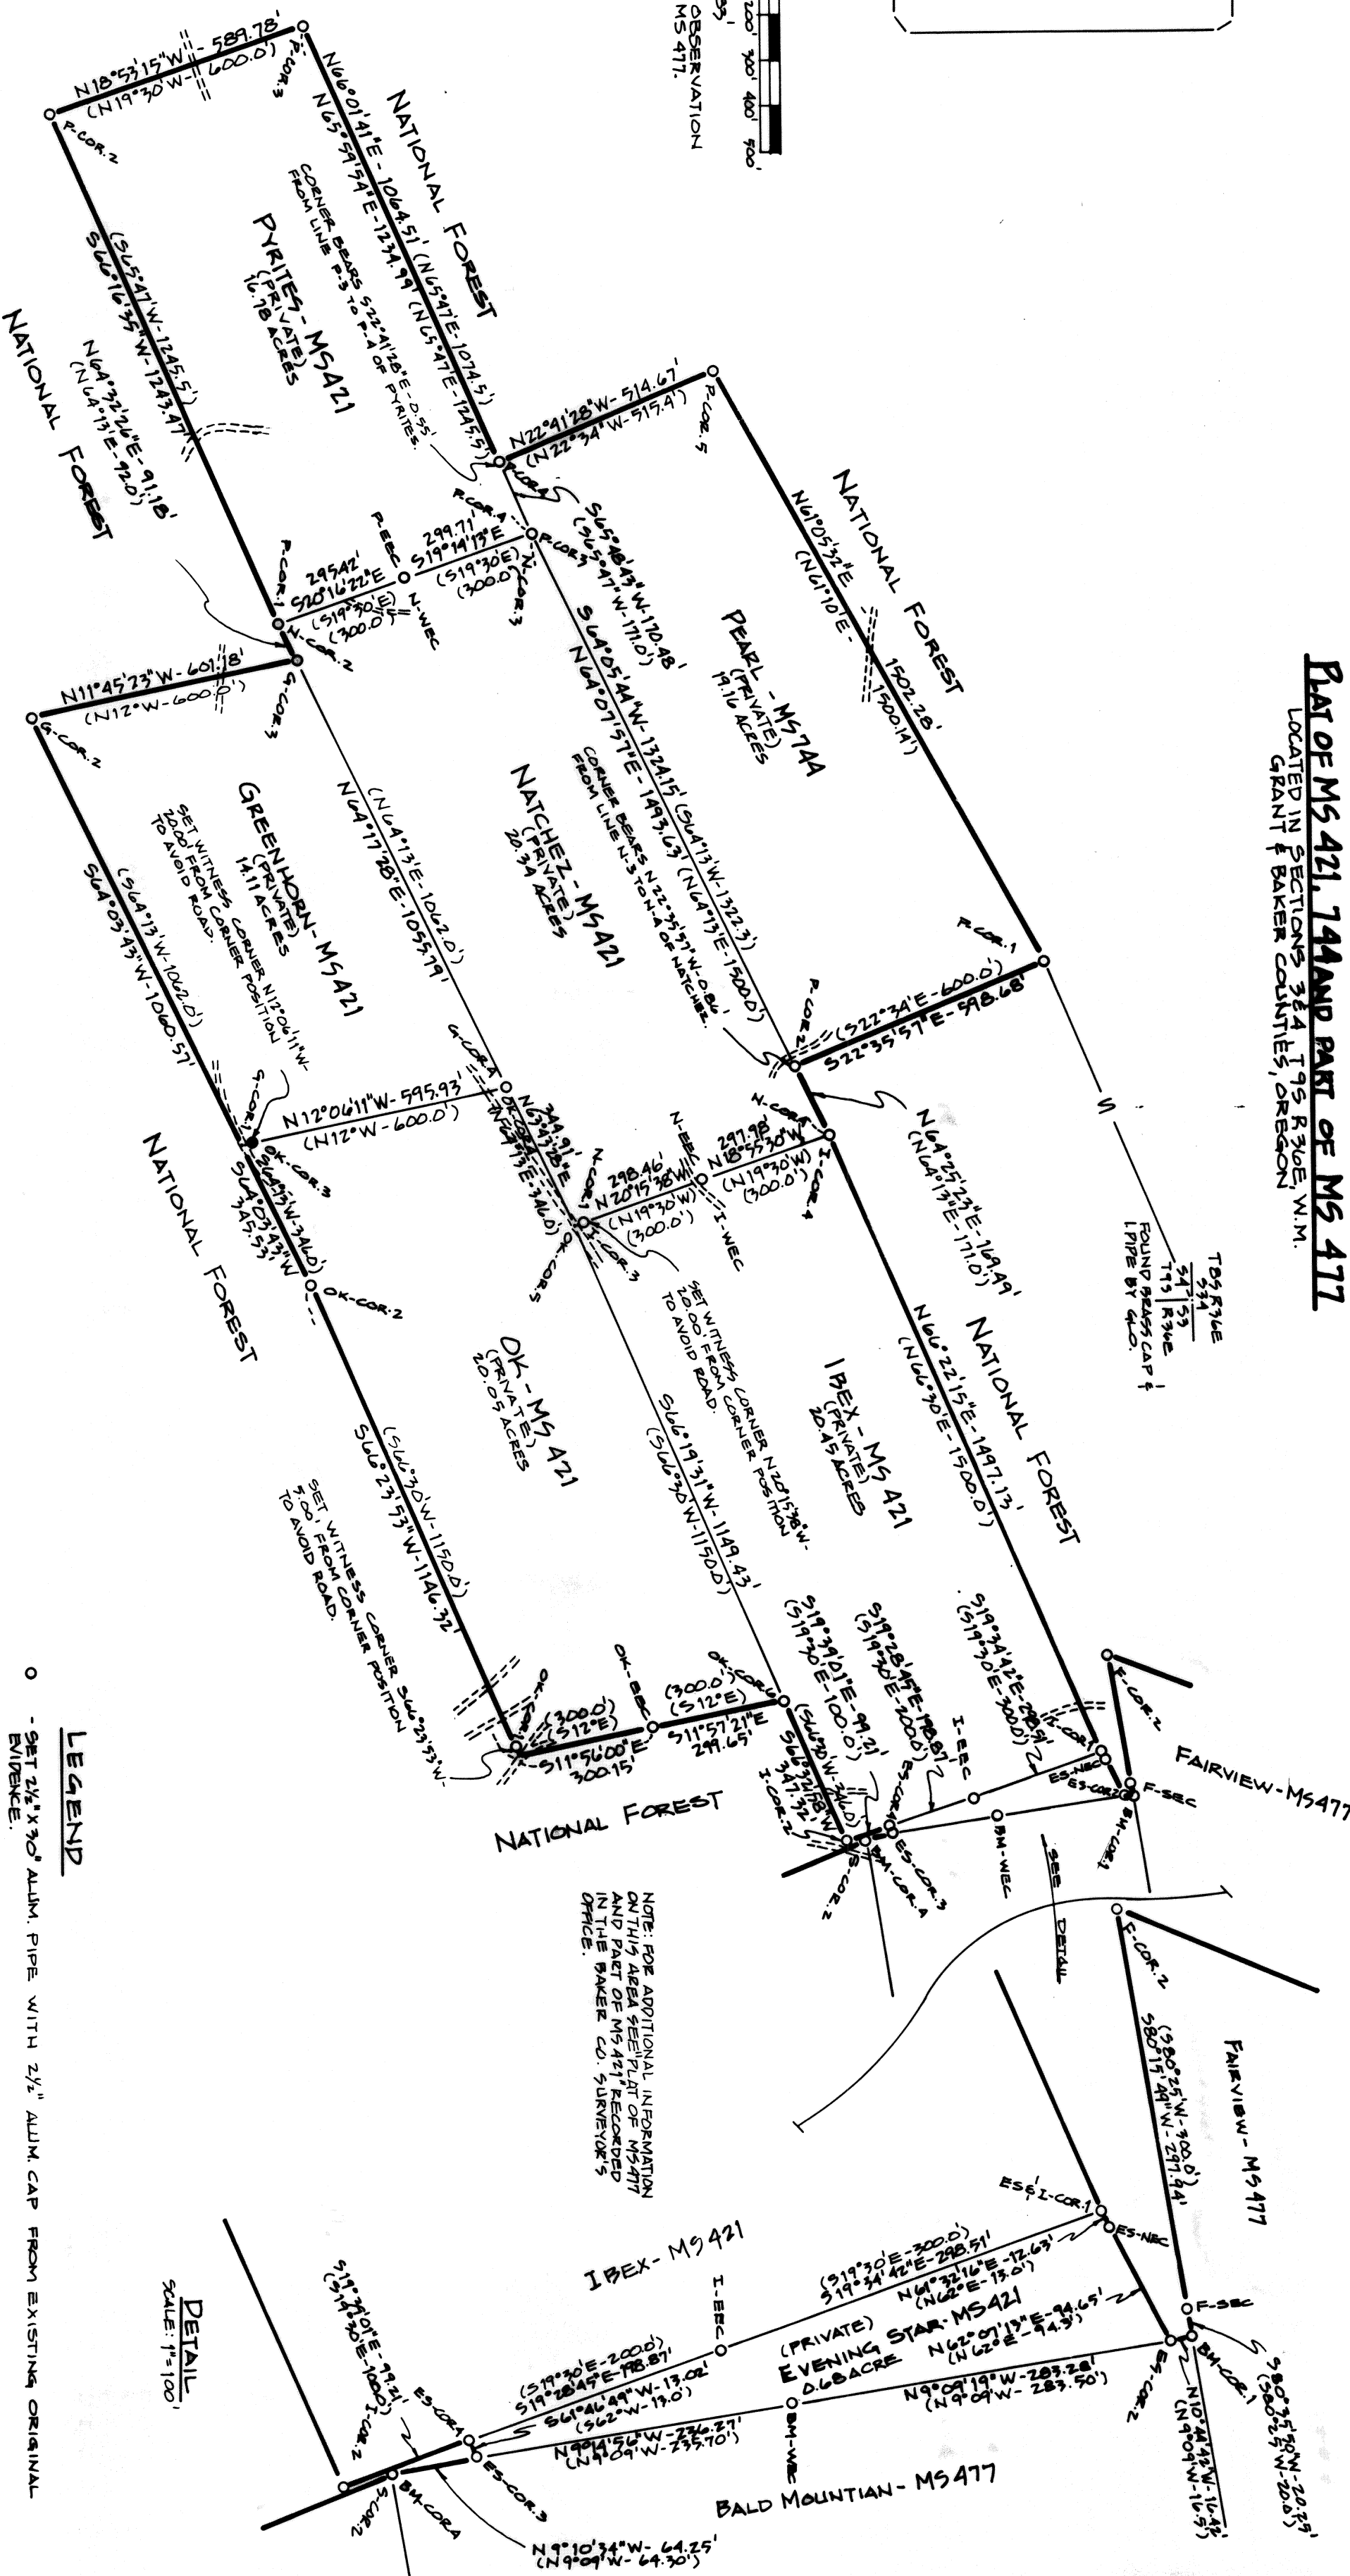

LEGEND

- - SET 2 1/2" X 30" ALUM. PIPE WITH 2 1/2" ALUM. CAP FROM EXISTING ORIGINAL EVIDENCE.
- - SET 2 1/2" X 30" ALUM. PIPE WITH 2 1/2" ALUM. CAP BY SURVEY. METHOD OF REESTABLISHMENT NOTED IN NARRATIVE.
- NATIONAL FOREST BOUNDARY - BOUNDARY POSTED.
- (X) - MEASUREMENTS FROM ORIGINAL MINERAL SURVEY NOTES.
- EXISTING ROADS CROSSED BY TRAVERSE LINES.

DETAIL
SCALE: 1"=100'

NOTES

FOR ADDITIONAL INFORMATION ON CORNERS REMONUMENTED - SEE FORMS FG-7100-57, FIELD BOOK REFERENCE - TRAVERSE BOOKS #2 & 3 AND MONUMENTATION BOOKS #1, 2 & 3 OF THE BALD IBEX CADASTRAL SURVEY.

HISTORY OF SURVEYS

MS 421 WAS ORIGINALLY SURVEYED BY CHARLES M. FOSTER, U.S. DEPUTY MINERAL SURVEYOR, FOR ARTHUR HILL IN AUGUST, 1901. MS 744 WAS ORIGINALLY SURVEYED BY I.R.A. L. HOFFMAN, U.S. DEPUTY MINERAL SURVEYOR, FOR E.M. BRIGGS IN JULY, 1911. MS 477 WAS ORIGINALLY SURVEYED BY ARTHUR PHILBRICK, U.S. DEPUTY MINERAL SURVEYOR, FOR THE BALD MOUNTAIN GOLD MINING COMPANY IN JUNE AND JULY, 1902.

SURVEYOR'S CERTIFICATION

I, WILLIAM R. WELLS, A REGISTERED PROFESSIONAL LAND SURVEYOR IN THE STATE OF OREGON, DO HEREBY CERTIFY THAT THIS PLAT, AND THE NOTES HEREON, ARE A CORRECT REPRESENTATION OF A SURVEY PERFORMED BY ME DURING THE MONTHS OF SEPTEMBER AND OCTOBER, 1985, AT THE REQUEST OF THE USDA, FOREST SERVICE. SAID PLAT AND NOTES WERE PREPARED IN ACCORDANCE WITH THE STATUTES OF THE STATE OF OREGON AND WITH THE ARTICLES OF THE CONTRACT.

W.R. Wells

WILLIAM R. WELLS, PLS
OREGON LICENSE NO. 1106.

FILED 12-31-85

BAKER COUNTY SURVEYOR
SURVEY NO. 9-36-72

W.R. Wells

REGISTERED
PROFESSIONAL
LAND SURVEYOR
JULY 22, 1977
WILLIAM R. WELLS
1106

WILLIAM R. WELLS, PLS LAND SURVEYING SERVICES P.O. BOX 1696 PENDLETON, OREGON 97801 PHONE: 503 276 6362	
Date: 11-27-85	Dr. By: WRW
CK By: WRW	No. 65-21
PROJECT: BALD IBEX CADASTRAL SURVEY PLAT OF MS 421 - MS 744 SURVEY PERFORMED FOR THE WALLAWA WHITMAN NATIONAL FOREST CONTRACT NO. 57-04H-5-9780N	