


CERTIFIED RECORD OF LAND CORNER MONUMENTATION

History of original corner establishment:

The corner was originally established by William Elmer under Mineral Survey No. 599 during August and September 1905. The original notes state that at the corner a scribed tamarack post 4' long by 6" sq. was set 2' in the ground and surrounded by a mound of earth from which:

- A 6" pine bears N51°45'E-8.50'.
- A 4½" ^{pine} bears N21°55'E-7'.
- Both marked 2-599 D.D. B.T.

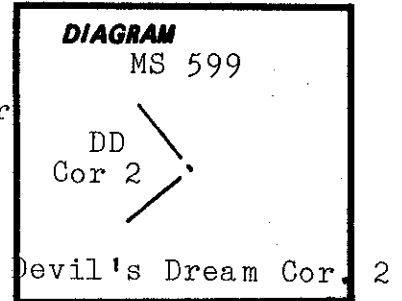

Description of corner evidence found:

Found a mound of earth and stone with the rotted remains of the post in a hole in the middle and the remains of the original post lying beside the mound. From the mound:

- A 9" dead lodgepole pine bears N22°E-7.3' with scribing visible on partly healed blaze (original bearing tree).
- A 10" dead lodgepole pine bears N51 3/4°E-8.8' with scribing visible on partly healed blaze (original bearing tree).

Description of monument and accessories | established to perpetuate the original location of this corner:

Set a 2½" by 30" aluminum pipe with a 2½" aluminum cap 24" in the ground and surrounded with a mound of earth and stone and placed the remains of the original post on the mound. From the monument:

- An 8" western larch bears S62½°E-30.3' scribed 2-DD-599 BT.
- A 9" western larch bears S10½°W-16.2' scribed 2-DD-599 BT.
- New bearing trees have a brass washer stamped PLS 1106 nailed to face of blaze.
- Attached sign 54-3 and 54-9 to each bearing tree and painted face of blaze and a 6" red band around each bearing tree. Set steel fence posts on National Forest Boundary SW and NW of corner and attached sign 54-9 to one post and sign 54-2 to both posts.

Used steel tape and staff compass with 20°E declination, measured to the center of the bearing trees.

This corner was remonumented on August 30, 1985.


Witness: John Tuttle

REGISTERED
PROFESSIONAL
LAND SURVEYOR

William R. Wells

OREGON
JULY 22, 1977
WILLIAM R. WELLS
1106

Cap is marked:
MS 599

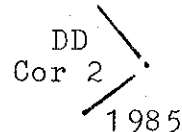

PLS 1106

Office of.....County Surveyor..... County of.....Baker.....
State of.....Oregon....., I hereby certify that the within instrument was filed in this office
for record on the..... day of....., 19.....

..... by
(COUNTY OFFICIAL) (DEPUTY)

Form R6-7100-57 (9/71)

FILED 10-29-85
BAKER COUNTY SURVEYOR
SURVEY NO. 9-36-75

☆ GPO—796-278