

CERTIFIED RECORD OF LAND CORNER MONUMENTATION

History of original corner establishment:


The corner was originally established by William Elmer under Mineral Survey No. 599, during August and September 1905. The original notes state that at the corner a scribed fir post 4' long by 6" sq. was set 1½' in the ground and surrounded by a mound of earth and stone from which:

A 5" sq. post was set in the ground pencilled North West Corner post Red Rock Quartz Claim bears N12°W-3.70'.

A 16" fir bears N63°27'E-31.10'.

A 24" fir bears S3°55'E-20.70'.

Both trees are marked 3-599M.D. and 4-599D.D. B.T.

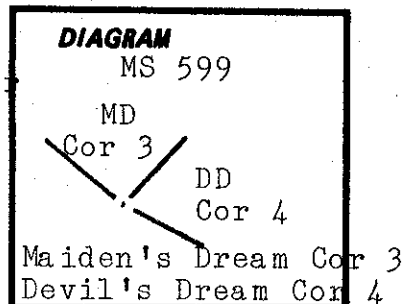

Description of corner evidence found:

A mound of stone with hole in the middle with the rotted post remains from which:

A 30" white fir stump bears N64½°E-31.8' (original bearing tree).

A very rotten fir stump bears S4°E-21'± (original bearing tree).

A mound of stone bears N12°W-3.7' which is the North West Corner post of the Red Rock Quartz Claim.

Description of monument and accessories established to perpetuate the original location of this corner:

Set a 2½" by 30" aluminum pipe with a 2½" aluminum cap 24" in the ground and surrounded with a mound of earth and stone from which:

An 8" white fir bears N82°W-15.9' scribed 3-MD-4-DD-599 BT.

A 7" white fir bears S3½°W-13.8' scribed 3-MD-4-DD-599 BT.

New bearing trees have a brass washer stamped PLS 1106 nailed to face of blaze. Attached sign 54-3 and 54-9 to each bearing tree and painted face of blaze and a 6" red band around each bearing tree. Set steel fence posts on National Forest Boundary NW and SE of corner and attached sign 54-9 to one post and sign 54-2 to both posts.

Used steel tape and staff compass with 20°E declination, measured to the center of the bearing trees.

This corner was remonumented on August 30, 1985.

Witness: John Tuttle

Cap is marked:
MS 599

MD
Cor 3

DD
Cor 4

1985
PLS 1106

REGISTERED
PROFESSIONAL
LAND SURVEYOR

William R. Wells

OREGON
JULY 22, 1977
WILLIAM R. WELLS
1106

Office of.....County Surveyor.....Baker
State of.....Oregon....., I hereby certify that the within instrument was filed in this office
for record on the.....day of....., 19.....
.....by.....
(COUNTY OFFICIAL) (DEPUTY)

Form R6-7100-57 (9/71)

FILED 10-29-85

☆ GPO-798-276

BAKER COUNTY SURVEYOR

SURVEY NO 9-36-76