

CERTIFIED RECORD OF LAND CORNER MONUMENTATION


History of original corner establishment:

The corner was originally established by William Elmer under Mineral Survey No. 599, during the survey of August and September 1905. The original notes state that at the corner a scribed pine post $3\frac{1}{2}$ ' long by 5" sq. was set $1\frac{1}{2}$ ' in the ground and surrounded by a mound of earth and stone from which:

A 10" fir bears S21°58'W-35.20'.

A 10" pine bears N41°28'E-9.35'.

Both marked 2-599M.D., 1-599D.D. B.T.

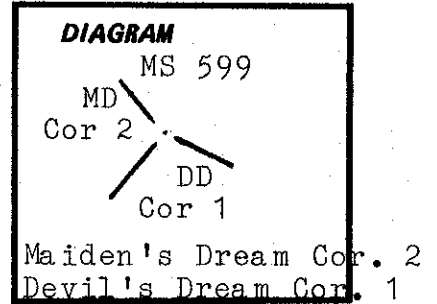

Description of corner evidence found:

Found a mound of earth and stone and the rotted remains of the post at ground level from which:

A 25" white fir bears S24°W-35.5' with healed blaze (original bearing tree).


Description of monument and accessories I established to perpetuate the original location of this corner:

Set a $2\frac{1}{2}$ " by 30" aluminum pipe with a $2\frac{1}{2}$ " aluminum cap 24" in the ground and surrounded with a mound of earth and stone. Placed the remains of the post on the mound. From the monument:

A 12" white fir bears N39½°E-31.5' scribed 2-MD-1-DD-599 BT.

New bearing tree has a brass washer stamped PLS 1106 nailed to face of blaze. Attached sign 54-3 and 54-9 to each bearing tree and painted face of blaze and a 6" red band around each bearing tree. Set steel fence posts on National Forest Boundary NW and SE of corner and attached sign 54-9 to one post and sign 54-2 to both posts.


Cap is marked:

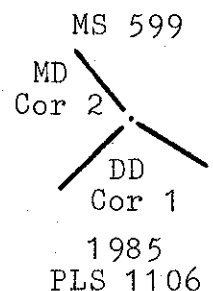


Used steel tape and staff compass with 20°E declination, measured to the center of the bearing trees.

This corner was remonumented on August 30, 1985.

Witness: John Tuttle

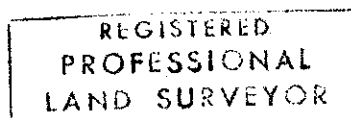

William R. Wells

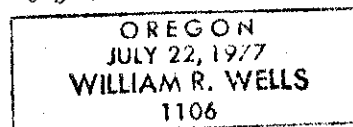

Office of.....County Surveyor.....County of.....Baker
State of.....Oregon....., I hereby certify that the within instrument was filed in this office
for record on the..... day of....., 19.....
..... by
(COUNTY OFFICIAL) (DEPUTY)

Form R6-7100-57 (9/71)

☆U.S. GOVERNMENT PRINTING OFFICE-1983-793-276

FILED 10-29-85
BAKER COUNTY SURVEYOR
SURVEY NO. 9-36-77