

CERTIFIED RECORD OF LAND CORNER MONUMENTATION

A-23 T 9 S R 36 E

History of original corner establishment:

Corner established by Eugene P. McCornack under Contract No 398, dated August 15, 1881. Surveyor General records state: Set post 3ins square 24ins in ground on steep East hillside for $\frac{1}{4}$ sec cor marked $\frac{1}{4}$ S on N face from which: A fir 12ins dia bears N75°W, 38 lks dist marked $\frac{1}{4}$ S BT. A fir 14ins dia bears S55°W, 13 lks dist marked $\frac{1}{4}$ S BT.

CORNER CHANGED to refer to sec 1 only by Otis O. Gould under special instructions dated Nov 27, 1935, under Group No 179. Gould's records state: The $\frac{1}{4}$ sec cor of secs 1 and 36 which is the badly weathered remains of old wood post loosely set with scribe marks not legible, at point for cor...Set an iron post 3ft long 1in dia 27ins in ground with marked stake deposited at the base for $\frac{1}{4}$ sec cor of sec 1 only with brass cap marked (as shown in corner diagram) from which: A fir stump 12 ins dia bears N75°W, 29 lks dist marked $\frac{1}{4}$ S BT obliterate marks, old BT. A fir 36 ins dia bears S55°W, 13 lks dist marks grown over, old BT. A fir 6 ins dia bears S52°E, 37 lks dist marked $\frac{1}{4}$ S1 BT, new BT.

DIAGRAM

$\frac{1}{4}$ S 1
1937

Description of corner evidence found:

Found a 2 $\frac{1}{2}$ " brass cap on 1" iron post protruding 4" from mound of earth marked as shown in corner diagram.

A fir 29 ins dia bears S55°W, 8.6 ft with healed blaze (old BT)
A fir 10 ins dia bears S52°E, 23.7 ft with healed blaze.


Description of monument and accessories | established to perpetuate the original location of this corner:

Corner monument maintained to USFS standards as follows...cleared brush and debris from around cor monument. Placed 6' steel fence post E of cor with sign 54-9 attached.

Each original bearing tree has signs 54-3 and 54-9 attached below a 6 inch band of red paint.

Compass declination 19° East.

I hereby certify that the above corner monument was properly maintained to U.S.F.S. standards under my supervision and witnessed by Willard Hulick on August 2, 1986.

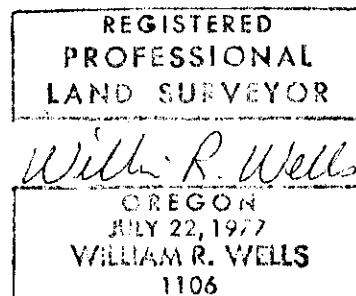

Office of.....County Surveyor.....County of.....Baker.....
State of.....Oregon....., I hereby certify that the within instrument was filed in this office
for record on the..... day of....., 19.....

..... by
(COUNTY OFFICIAL)

(DEPUTY)