

CERTIFIED RECORD OF LAND CORNER MONUMENTATION

Corner No.1, Anululu Mill Site, M.S. 382 B

History of original corner establishment:

Corner **ORIGINALLY** established by C.M.Foster, U.S. Deputy Mineral Surveyor under instructions dated **December 7, 1899**, for mineral survey no. 382A & B.

Surveyor General records state: A pine post 4 ft long 4 ins square, set 18 ins in the ground scribed 1-382-B whence: A tamarack 24 ins dia bears S18°E, 9.3 ft dist blazed and scribed No. 1-382-B, BT. A tamarack 12 ins dia bears N62°E, 28.2 ft dist blazed and scribed 1-382-B, BT.

Corner **RECOVERED** and **PERPETUATED** by J.R.Mitchell, experienced corner recovery technician, as noted below. No record filed with Baker County Surveyor.



Description of corner evidence found:

No trace of original pine post.

Found a 2½" dia brass cap attached to a 1" dia galvanized iron pipe in rock mound from which: (brass cap mkd as shown to right & below)
Old BT: A rotten western larch stump flush with ground brs N67°E, (record, N62°E) 28.2' dist per record. No trace of tree.

Old BT: A western larch 30" dia with fully healed blaze brs S06½°E, (record, S18°E) 9.3' dist per record.

J.R.Mitchell BT: A white fir 9" dia brs S31½°E, 8.9' dist marked "1 382B BT" on partially healed blaze.

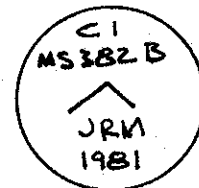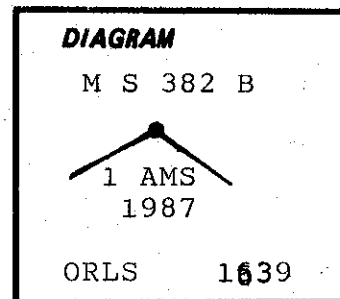

Description of monument and accessories I established to perpetuate the original location of this corner:


At position of JRM brass cap monument which is the best available evidence of original corner position...

Removed brass cap monument and replaced with 2" x 30" aluminum pipe with 2½" aluminum cap 25" in ground surrounded with a mound of earth and stone. Set 6' steel fence post alongside. No signs attached to fence post per landowner request. Cap marked as shown in corner diagram.


Recovered original and JRM BT's signed with signs 54-3 - no paint or signs 54-9 attached per landowner request.

Compass declination 20° East.

I hereby certify that the above corner monument was properly remonumented to U.S.F.S. standards by me and witnessed by Bill Gohring on October 7, 1987.

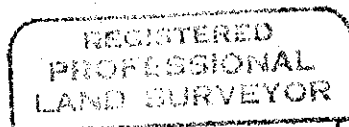

William L. Hanley

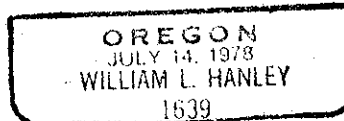

Office of.....County.....Surveyor..... County of.....Baker.....
State of.....Oregon....., I hereby certify that the within instrument was filed in this office
for record on the..... day of....., 19.....

..... by
(COUNTY OFFICIAL) (DEPUTY)