

CERTIFIED RECORD OF LAND CORNER MONUMENTATION

Corner No.2, Annululu Lode, M.S. 382 A

History of original corner establishment:



Corner ORIGINALLY established by C.M.Foster, U.S. Deputy Mineral Surveyor under instructions dated December 7, 1899, for mineral survey no. 382A & B.

Surveyor General records state: A pine post 4' long 4" square set 18" in ground scribed 2-382-A. Old location SW corner S51°45'W, 75' dist whence: A fir 8" dia brs N46°20'W, 44.3' dist blazed and scribed 2-382-A BT. A fir 30" dia brs N5°45'W, 26.7' dist blazed and scribed 2-382-A BT.

Corner RECOVERED and PERPETUATED by J.R.Mitchell, experienced corner recovery technician, as noted below. No record filed with Baker County Surveyor.

Description of corner evidence found:

A 2½" brass cap on 1" galvanized iron pipe in rock mound (as shown beside) with 4" x 4" x 30" wood post scribed COR 3 BHE one face and MS on other. JRM-BT: A lodgepole pine 7" dia brs N22°W, 34.0' dist mkd AN2 MS 382ABT on partially healed blaze. OBT: A 24" white fir brs N46°20'W, 44.3' dist per record. A rotten fir stub 8' high with pitched over blaze alongside scribed OR NO2 ANNULULU MS 382 BT brs N05°45'W, 26.7' dist per record.

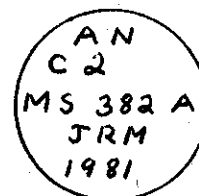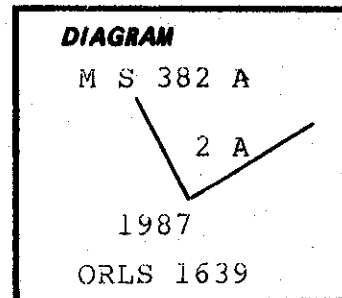

Description of monument and accessories I established to perpetuate the original location of this corner:

At position of JRM brass cap monument which is the best remaining evidence of original bearing tree...

Removed JRM brass cap, destroyed rock mound and set post alongside. Set 2" x 30" aluminum pipe with 2½" aluminum cap 25" in ground surrounded with rock mound. Cap marked as shown in corner diagram. Set steel fence post with signs 54-2 & 54-9 attached.

Each BT has signs 54-3 & 54-9 attached below a 6" band of red paint, and painted blaze. Compass declination 20° East.

I hereby certify that the above corner monument was properly remonumented to U.S.F.S. standards by me and witnessed by Bill Gohring on October 14, 1987.

REGISTERED
PROFESSIONAL
LAND SURVEYOR

William L. Hanley

OREGON
JULY 13, 1978
WILLIAM L. HANLEY
1639

Office of.....County Surveyor.....County of.....Baker.....
State of.....Oregon....., I hereby certify that the within instrument was filed in this office
for record on the.....day of....., 19.....

(COUNTY OFFICIAL)

(DEPUTY)

Form R6-7100-57 (9/71)

GPO-791-311

FILED 2-2-88
BAKER COUNTY SURVEYOR
SURVEY NO. 9-36-92