


CERTIFIED RECORD OF LAND CORNER MONUMENTATION

Corner No.3, Annululu Lode, M.S. 382 A

History of original corner establishment:

Corner ORIGINALLY established by C.M.Foster, U.S. Deputy Mineral Surveyor under instructions dated December 7, 1899, for mineral survey no. 382A & B.

Surveyor General records state: A fir post 4' long 4" square set 18" in ground scribed 3-382-A. Identical with old NW cor of location. A fir 16" dia brs N83°E, 10.5' dist blazed and scribed 3-382A BT. A fir 10" dia brs N20°20'W, 12' dist blazed and scribed 3-382A BT.

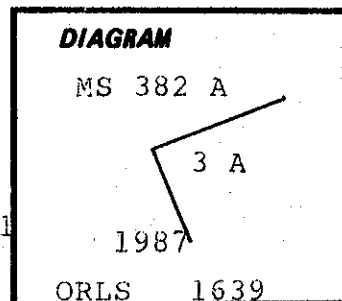

Corner RECOVERED and PERPETUATED by J.R.Mitchell, experienced corner recovery technician, as noted below. No record filed with Baker County Surveyor.


Description of corner evidence found:

Rotten fir post found wired alongside JRM wood post.

A 2½" brass cap on 1" galvanized iron pipe in rock mound (as shown beside) with 3" x 4" x 45" wood post alongside scribed Cor 2 BHE from which:

OBT: A 36" dia white fir brs N83°E, 10.5' dist per record with partially healed blaze.

A 34" white fir brs N20°W, 12.0' dist per record with partially healed blaze.

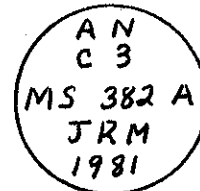

Description of monument and accessories I established to perpetuate the original location of this corner:


At position of JRM brass cap monument which is the best remaining evidence of original corner...

Removed brass cap monument and replaced with 2" x 30" aluminum pipe with 2½" aluminum cap 25" in ground surrounded with rock mound. Cap marked as shown in corner diagram. Set steel fence post with signs 54-2 & 54-9 attached.


Each bearing tree has a sign 54-3 & 54-9 attached below a 6" band of red paint and a painted blaze.

Compass declination 20° East.

I hereby certify that the above corner monument was properly remonumented to U.S.F.S. standards by me and witnessed by Bill Gohring on October 14, 1987.

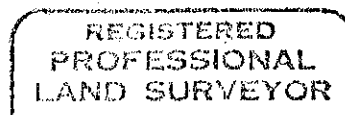

William L. Hanley

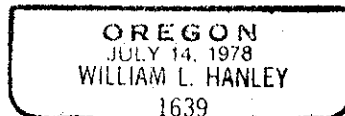

Office of.....County Surveyor..... County of.....Baker.....
State of.....Oregon....., I hereby certify that the within instrument was filed in this office
for record on the..... day of....., 19.....

..... by
(COUNTY OFFICIAL)

(DEPUTY)