

CERTIFIED RECORD OF LAND CORNER MONUMENTATION

Corner No.1, Myrtle Lode, M.S. 375

History of original corner establishment:


Corner ESTABLISHED by John Hagel, U.S. Deputy Mineral Surveyor, under instructions dated September 18, 1899, for the survey of MYRTLE QUARTZ CLAIM, M.S. 375, performed in conjunction with the survey of the LILAC QUARTZ CLAIM, M.S. 376, under instructions dated the same date.

Surveyor General records state: Begining at Cor No 1, identical with the NE cor of location. Set a fir post 4" square 4½' long 18" in ground with a mound of stones around it, marked Myrtle Cor 1-375 for Cor No 1.

A spruce tree 12" dia brs S51°05'W, 18.5 ft.

A white fir tree 12" in dia brs S06°30'W, 9.4 ft.

Both blazed and marked Myrtle Cor 1-375 BT.

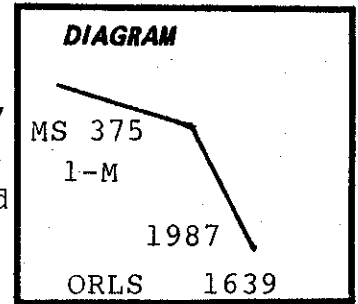

Description of corner evidence found:

Found a rock mound with rotten wood remains in its center & partially covered by a 15" dia rotten windblow white fir, from which:

A 28" dia white fir with fully healed blaze brs S01°W (record, S06°30'W), 9.4' dist per record.

A 30" dia spruce with fully healed blaze brs S51°05'W per record, 13.1' dist(record,18.6' dist).

NOTE: These trees were also blazed and marked as the official accessories to the "LILAC" Cor No 1 MS 376. Mammuth Gulch brs N77½°W, 11.2' dist per record.

Description of monument and accessories I established to perpetuate the original location of this corner:

At position of center of rock mound, removed wood post and replaced with...

Set 2 " x 30" aluminum pipe with 2½" aluminum cap 25" in ground with 5" projecting out of the ground surrounded with rock mound. Cap marked as shown in corner diagram. Set steel fence post alongside with signs 54-2 & 54-9 attached.

New bearing trees established:

A spruce 12" dia brs N33½°E, 29.4' dist mkd M-1-375 BT.

New bearing trees have a brass washer stamped PLS 1639 nailed to face of blaze. Attached signs 54-3 & 54-9 and painted face of blaze and 6" band of red paint around each BT.

Compass declination 20° East.

I hereby certify that the above corner monument was properly REMONUMENTED to U.S.F.S. standards by me and witnessed by Bill Gohring on November 17, 1987.

**REGISTERED
PROFESSIONAL
LAND SURVEYOR**

William L. Hanley

**OREGON
JULY 14, 1978
WILLIAM L. HANLEY
1639**

Office of.....County Surveyor.....County of.....Baker
State of.....Oregon....., I hereby certify that the within instrument was filed in this office
for record on the..... day of....., 19.....

..... by
(COUNTY OFFICIAL) (DEPUTY)