

CERTIFIED RECORD OF LAND CORNER MONUMENTATION

Corner No.2, Myrtle Lode, M.S. 375

History of original corner establishment:


Corner ESTABLISHED by John Hagel, U.S. Deputy Mineral Surveyor, under instructions dated September 18, 1899, for the survey of MYRTLE QUARTZ CLAIM, M.S. 375, performed in conjunction with the survey of the LILAC QUARTZ CLAIM, M.S. 376, under instructions dated the same date.

Surveyor General records state: Identical with the SE corner of location...Set a tamarack post 4" square 4½ ft. long 18" in ground with mound of earth around it, marked it Myrtle Cor 2-375 for Cor No 2.

A tamarack tree 12" dia brs N81°W, 15.4 ft.

A tamarack tree 10" dia brs S16°W, 19.0 ft.

Both blazed and marked Myrtle Cor 2-375 BT.

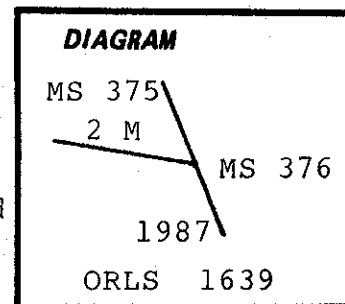

Description of corner evidence found:

No trace of original corner monument in area obliterated by logging operation.

A 19" western larch (tamarack) with fully healed blaze brs N81°W, 15.4' dist per record.

Root remains of wind blown western larch (tamarack) obliterated by previous logging activity brs S16°W, 19.0' dist per record. Remains of tree not found.

Description of monument and accessories | established to perpetuate the original location of this corner:

At position determined by reversed record bearing & distance from recovered BT and BT remains...

Set 2 " x 30" aluminum pipe with 2½" aluminum cap 25" in ground with 5" projecting out of the ground surrounded with rock mound. Cap marked as shown in corner diagram. Set steel fence post alongside with signs 54-2 & 54-9 attached.

New bearing tree established:

A 14" douglas fir brs S46°W, 26.4' mkd M-2-375 BT.

New bearing trees have a brass washer stamped PLS 1639 nailed to face of blaze. Attached signs 54-3 & 54-9 and painted face of blaze and 6" band of red paint around each BT.

Compass declination 20° East.

I hereby certify that the above corner monument was properly REMONUMENTED to U.S.F.S. standards by me and witnessed by Bill Gohring on November 17, 1987.

REGISTERED
PROFESSIONAL
LAND SURVEYOR

William L. Hanley

OREGON
JULY 14, 1978
WILLIAM L. HANLEY
1639

Office of.....County Surveyor.....County of.....Baker.....

State of.....Oregon....., I hereby certify that the within instrument was filed in this office for record on the..... day of....., 19.....

..... by
(COUNTY OFFICIAL) (DEPUTY)