

CERTIFIED RECORD OF LAND CORNER MONUMENTATION

Corner No.2, Boulder Lode, M.S. 447

History of original corner establishment:

Corner ORIGINALLY established by C.M.Foster U.S. Deputy Surveyor under instructions for MS 447 and dated September 25, 1901.

Surveyor General records state: A pine post 4½' long 4" square set 18" in ground surrounded with mound of earth scribed Boulder-2-447 from which: The SW cor of amended location bears S 60°20'W, 280' dist... A fir 8" dia brs N18°30'E, 17' dist blazed & scribed Boulder 2-477-BT. A tamarack 10" dia brs S51°30'E, 26.4' dist blazed & scribed Goulder 2-447-BT.

Corner RECOVERED and PERPETUATED by J.R.Mitchell, experienced corner recovery technician, as noted below. No record filed with Baker County Surveyor.



Description of corner evidence found:

A 2½" brass cap on 1" galvanized iron pipe in rock mound with rotten remains of wood post alongside, cap marked as shown to right, from which:

JRM BT: A western larch 6" dia brs N83°W, 23.4' dist mkd BL2 MS 447 BT on partially healed blaze.

OBT: A western larch 14" dia brs S51½°E, 26.4' dist per record with partially healed blaze.

A rotten fir root brs N18½°E, 17.0' dist per record.

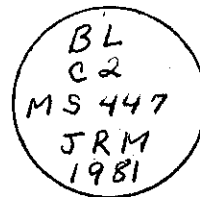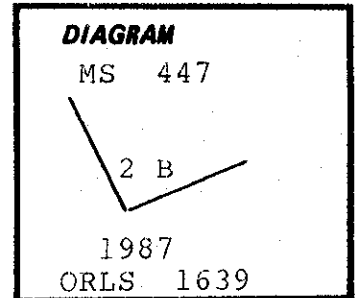

Description of monument and accessories | established to perpetuate the original location of this corner:

At position of JRM brass cap monument which is the best remaining evidence of original corner...


Removed brass cap monument and replaced with 2 " x 30" aluminum pipe with 2½" aluminum cap 25" in ground surrounded with rock mound. Cap marked as shown in corner diagram. Set steel fence post with signs 54-2 & 54-9 attached.

No new bearing trees established.


Each bearing tree has a sign 54-3 & 54-9 attached below a 6" band of red paint and a painted blaze.

Compass declination 20° East.

I hereby certify that the above corner monument was properly remonumented to U.S.F.S. standards by me and witnessed by Bill Gohring on October 14, 1987.

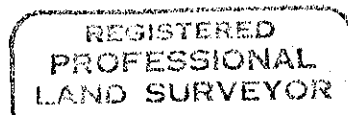

William L. Hanley

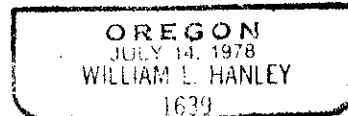

Office of.....County Surveyor.....County of.....Baker
Oregon
State of....., I hereby certify that the within instrument was filed in this office
for record on the..... day of....., 19.....

..... by
(COUNTY OFFICIAL) (DEPUTY)