


CERTIFIED RECORD OF LAND CORNER MONUMENTATION

Corner No.2, Bunker Hill Lode, M.S. 329

History of original corner establishment:

Corner ESTABLISHED by C.M.Foster, U.S. Deputy Mineral Surveyor, under instructions dated November 4, 1896, for the survey of the BUNKER HILL QUARTZ CLAIM, MS 329.

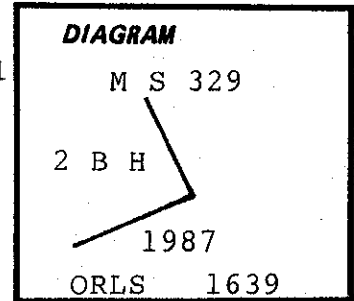

Surveyor General records state: To Corner No 2 identical with location corner. A post 4 inches square $4\frac{1}{2}$ feet long set 18 inches in the ground with mound of earth scribed 2-329.

A black pine 10 inches in dia bears $S15\frac{1}{2}^{\circ}W$, 10 ft dist blazed and scribed BT 2-329.

A black pine bears $S54^{\circ}W$, 13 ft dist and 10 inches in dia blazed and scribed BT 2-329.

Description of corner evidence found:

A rock mound with 4"x4"x30" wood post marked "COR 4 B" on one face, from which:

A white fir 3" dia brs $N03^{\circ}W$, 26' with location tag marked "COR#2MS 329 brs South, 3 ft dist dated 9-3-73" by JRM(NOTE: JRM recovery notes state he found a sawed lodgepole pine stump with long butt and a down and decaying lodgepole pine, both with evidence of scribing - no remains of these accessories recovered and JRM recovery rejected).

Description of monument and accessories I established to perpetuate the original location of this corner:

At position of wood post in center of rock mound...

Removed wood post & replaced with a 2 " x 30" aluminum pipe with $2\frac{1}{2}$ " aluminum cap 25" in ground surrounded with rock mound. Cap marked as shown in corner diagram. Set steel fence post with signs 54-2 & 54-9 attached.

New bearing trees established:

A lodgepole pine 8" diam brs $S66\frac{1}{2}^{\circ}E$, 22.3' mkd BH-2-329 BT.


A lodgepole pine 7" diam brs $N72^{\circ}E$, 44.5' mkd BH-2-329 BT.

A lodgepole pine 8" dia brs $N50^{\circ}E$, 28.6' typical blaze-no scribes.


New bearing trees have a brass washer stamped PLS 1639 nailed to face of blaze. Attached signs 54-3 & 54-9 and painted face of blaze and 6" band of red paint around each BT.

Compass declination 20° East.

I hereby certify that the above corner monument was properly REMONUMENTED. to U.S.F.S. standards by me and witnessed by Bill Gohring on October 29, 1987.

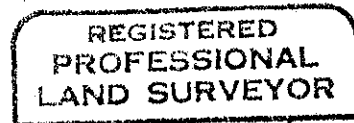

William L. Hanley

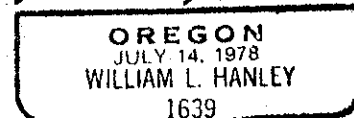

Office of.....County Surveyor.....County of.....Baker.....
Oregon
State of....., I hereby certify that the within instrument was filed in this office
for record on the..... day of....., 19.....

..... by
(COUNTY OFFICIAL) (DEPUTY)