

CERTIFIED RECORD OF LAND CORNER MONUMENTATION

Corner No.4, Bunker Hill Lode, M.S. 329 also Corner No.4, Lilac Lode, M.S. 376

History of original corner establishment:

Corner ESTABLISHED by C.M.Foster, U.S. Deputy Mineral Surveyor, under instructions dated November 4, 1896, for the survey of the BUNKER HILL QUARTZ CLAIM, MS 329.

Surveyor General records state: A post 4 ins square $4\frac{1}{2}$ ft long planted 18 ins in ground with mound of earth scribed 4-329, identical with old corner. A fir 12 ins in dia brs N28°W, 10 feet distant blazed BT 4-329. A fir 15 ins dia brs S24°W, 7 feet distant blazed BT 4-329.

Corner AMMENDED and perpetuated by John Hagel, U.S. Deputy Mineral Surveyor, under instructions dated September 18, 1899, for the survey of the LILAC QUARTZ CLAIM, MS 376.

Surveyor General records state: To Cor No 4. Identical with the NE cor of location, identical with Cor No 4 of Bunker Hill Lode Sur 329. Found a fir post 4 ins square 3 ft above the ground with a mound of earth around it marked "Bunker Hill Cor 4-329" marked it "Lilac

Description of corner evidence found: Cor 4-376" for Cor No 4. A black pine tree 10 ins dia brs N17°55'E, 30.6 ft. A white fir tree 12 ins dia brs S83°W, 15.1 ft. Both blazed and marked Lilac Cor 4-376 BT.

A rock mound with old hand-hewed location post lying South 10' from which:

A white fir 21" dia brs S26°W, 6.7' dist(record, S24°W, 7') with fully healed blaze for BH-4-329 BT.

A white fir 20" dia brs N18°W, 10.0' dist (record, N28°W, 10') with fully healed blaze for BH-4-329 BT.

A white fir 16" dia brs S88½°W, 14.8' dist (record, S83°W, 15.1') with scribes "-376" visible on blaze opened this date for L-4-376 BT.

(NOTE: Two white fir trees, both 23" diam with fully healed typical blazes, signed and reported by JRM in his record of recovery dated 9-17-73, do not conform to the record of MS 329 or MS 376 or to this retracement and are rejected. They are located easterly about 50' from true corner recovered this survey.)

Description of monument and accessories I established to perpetuate the original location of this corner:


At position of center of rock mound...

Set 2 " x 30" aluminum pipe with 2½" aluminum cap 25" in ground with 5" projecting out of ground surrounded with rock mound. Cap marked as shown in corner diagram. Set steel fence post alongside with signs 54-9 & 54-2 attached.

All original bearing trees have 6" band of red paint around and painted blazes and signs 54-3 and 54-9 attached - removed signs 54-3 and 54-4 placed by JRM on trees rejected this survey as original BT's.

Compass declination 20° East.

I hereby certify that the above corner monument was properly REMONUMENTED to U.S.F.S. standards by me and witnessed by Bill Gohring on October 8, 1987.

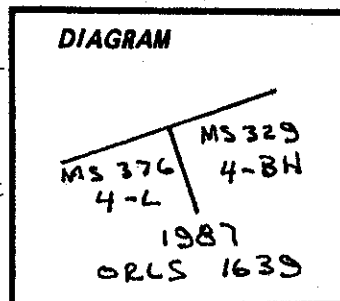

REGISTERED
PROFESSIONAL
LAND SURVEYOR

William L. Hanley
OREGON
JULY 14, 1978
WILLIAM L. HANLEY
1639

Office of.....County Surveyor.....County of.....Baker.....
Oregon

State of....., I hereby certify that the within instrument was filed in this office
for record on the..... day of....., 19.....

..... by
(COUNTY OFFICIAL) (DEPUTY)