

CERTIFIED RECORD OF LAND CORNER MONUMENTATION

Corner No.3, Bunker Hill Lode, M.S. 329, also Corner No.3, Lilac Lode, M.S. 376

History of original corner establishment:

Corner ESTABLISHED by C.M.Foster, U.S. Deputy Mineral Surveyor, under instructions dated November 4, 1896, for the survey of the BUNKER HILL QUARTZ CLAIM, MS 329.

Surveyor General records state: To Cor No 3, a post 4 ins square $4\frac{1}{2}$ ft long, set 18 ins in ground with mound of earth scribed 3-329 identical with old location corner. A fir 9 ins dia brs S75°W, 18 ft dist blazed BT 3-329. A fir 7 ins dia brs N48°E, 33 ft dist blazed BT 3-329.

Corner AMMENDED and perpetuated by John Hagel, U.S. Deputy Mineral Surveyor, under instructions dated September 18, 1899, for the survey of the LILAC QUARTZ CLAIM, MS 376.

Surveyor General records state: Identical with the SE Cor of location, identical with Cor 3 Bunker Hill Lode Sur 329. Found a fir post 4 ins square 3 ft above ground with mound of earth around it marked "Bunker Hill Cor 3-329" marked it "Lilac Cor 3-376" for Cor No 3.

Description of corner evidence found: A tamarack tree 12 ins in diam bears N10°45'W, 19.0 ft. A tamarack tree 12 ins in diam bears N62°W, 6.5 ft. Both blazed and marked Lilac Cor 3-376 BT.


No trace of original fir post.

A white fir 17" diam brs N50°E, 33.0' (record states, N48°E, 33.0') mkd Cor No 3 MS No 329 BT on partially healed blaze.

A white fir 23" diam brs S35°E, 18.0' dist (MS 329 record, S75°W, 18.0') with fully healed blaze (NOTE: This blaze faces approximately N20°E).

A decaying western larch wind blown snag 10" dia with fragmentary scribing interpreted to read "Lilac Cor 3...BT" brs N73°W, 39.2' dist (positive determination of root hole for this tree indefinite).

Did not find other record MS 376 BT.

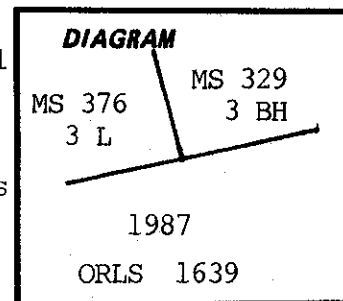

Description of monument and accessories | established to perpetuate the original location of this corner:

At position determined by distance intersection from original MS 329 BT's (this position also closely conforms to reversed record bearing and distance from recovered 17" dia white fir BT.

Set 2 " x 30" aluminum pipe with 2½" aluminum cap 25" in ground with 5" projecting out of ground surrounded with earth mound. Cap marked as shown in corner diagram. Set steel fence post alongside with signs 54-9 & 54-2 attached.

No new BT's established. Used trees for survey of BH-329 and placed tags with reestablished bearings and distances as measured this date. Attached signs 54-3 & 54-9 and painted face of blaze and a 6" band of red paint around each BT.

Compass declination 20° East.

I hereby certify that the above corner monument was properly REMONUMENTED to U.S.F.S. standards by me and witnessed by Bill Gohring on November 13, 1987.

REGISTERED
PROFESSIONAL
LAND SURVEYOR

William L. Hanley

OREGON
JULY 14, 1978
WILLIAM L. HANLEY
1639

Office of.....County Surveyor.....County of.....Baker.....
State of.....Oregon....., I hereby certify that the within instrument was filed in this office
for record on the..... day of....., 19.....

..... by
(COUNTY OFFICIAL) (DEPUTY)