

CERTIFIED RECORD OF LAND CORNER MONUMENTATION

Corner No.3, Boulder Lode, M.S. 447

History of original corner establishment:

Corner ORIGINALLY established by C.M.Foster U.S. Deputy Surveyor under instructions for MS 447 and dated September 25, 1901.

Surveyor General records state: On line 1-2 of the Annululu Lode MS 382 A. Apine post $4\frac{1}{2}$ ' long 4" square set 18" in ground, surrounded with a mound of earth scribed Boulder 3-447 from which: The NW cor post of amended location brs S72°30'W, 28' dist. A pine 10" dia brs S4°15'E, 18' dist blazed and scribed Boulder 3-447 BT. A tamarack 10" dia brs S41°30'W, 23.4' dist blazed and scribed Boulder 3-447 BT.

Corner RECOVERED and PERPETUATED by J.R.Mitchell, experienced corner recovery technician, as noted below. No record filed with Baker County Surveyor.



Description of corner evidence found:

No trace of original pine post.

A $2\frac{1}{2}$ " brass cap on 1" galvanized iron pipe in rock mound with 4" x 4" x 30" wood post alongside with scribes COR 4 BH MS (cap marked as shown) from which: JRM BT: A western larch 11" dia brs S26 $\frac{1}{2}$ °E, 16.8' dist mkd BL 3 MS 447 BT.

OBT: A western larch 17" dia brs S41 $\frac{1}{2}$ °W, 23.4' dist per record previously opened scribed "R..OR3-447...".

Decaying remains of small tree with ax mark & fragment scribe-origin indeterminate.

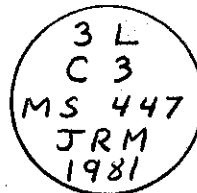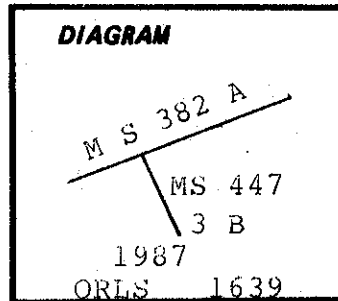

Description of monument and accessories | established to perpetuate the original location of this corner:

At position of JRM brass cap monument which is the best remaining evidence of original corner...

Removed brass cap monument and replaced with $2\frac{1}{2}$ " x 30" aluminum pipe with 2" aluminum cap 25" in ground surrounded with rock mound. Cap marked as shown in corner diagram. Set steel fence post with signs 54-2 & 54-9 attached.

No new bearing trees established.

Each BT has signs 54-3 & 54-9 attached below a 6" band of red paint.

Compass declination 20° East.

I hereby certify that the above corner monument was properly remonumented to U.S.F.S. standards by me and witnessed by Bill Gohring on October 14, 1987.

REGISTERED
PROFESSIONAL
LAND SURVEYOR

William L Hanley

OREGON
JULY 14, 1978
WILLIAM L. HANLEY
1639

Office of.....County Surveyor..... County of.....Baker.....
State of.....Oregon....., I hereby certify that the within instrument was filed in this office
for record on the..... day of....., 19.....

..... by
(COUNTY OFFICIAL) (DEPUTY)