

CERTIFIED RECORD OF LAND CORNER MONUMENTATION

East end center, Annululu Lode, also West end center Chapman Lode M.S. 382 A.


History of original corner establishment:

Corner originally ESTABLISHED by C.M.Foster, U.S. Deputy Mineral Surveyor under instructions dated December 7, 1899, for mineral survey no. 382 A & B.

Surveyor General records state: A pine post 4 ft long 4 ins square, set 18 ins in ground scribed E cen end-382-A. A pine 6 ins dia brs S7°15'E, 15 ft dist blazed E cen end-382-A BT.

Identical with E center end of Annululu Lode of this survey, whence...A fir 4 ins dia brs N2°W, 16 ft dist blazed W cen end-382 A BT.

Corner RECOVERED and PERPETUATED by J.R.Mitchell, experienced corner recovery technician, as noted below. No record filed with Baker County Surveyor.

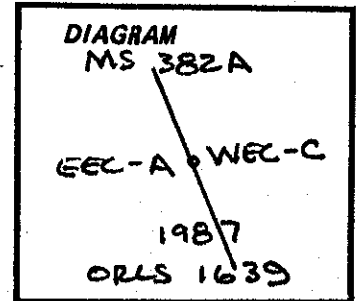

Description of corner evidence found:


Found a 2½" brass cap on 1" galvanized iron pipe in earth and stone mound as shown beside from which:

OBT: A dead lodgepole pine 19" dia brs N4°E, 16' dist(record, N2°W) mkd Chapman MS 382 on partially healed blaze.

A lodgepole pine wind blow 12" dia brs S2°E, 15.0'(record, S7°E) mkd ANNULULU MS 382 BT on partially healed blaze.

JRM BTs: A western larch 12" dia brs S61°W, 18.0' mkd CH WEC MS 382 A BT on partially healed blaze.

A spruce 11" dia brs N88°W, 17.2' mkd CH WEC MS 382 BT on partially healed blaze.

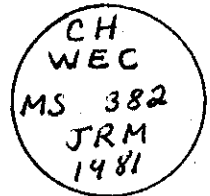


Description of monument and accessories | established to perpetuate the original location of this corner:

At position of JRM brass cap monument which is the best available evidence of original corner position...


Removed brass cap monument & replaced with 2 " x 30" aluminum pipe with 2½" aluminum cap 20" in ground surrounded with a mound of earth and stone. Set 6' steel fence post alongside with signs 54-2 & 54-9. Cap marked as shown in corner diagram. Painted 6" band of red around each OBT and JRM-BT.

Compass declination 20° East.

I hereby certify that the above corner monument was properly REMONUMENTED to U.S.F.S. standards by me and witnessed by Bill Gohring on November 04, 1987.

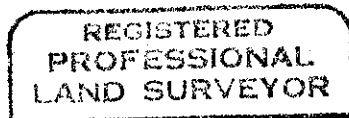

William L. Hanley

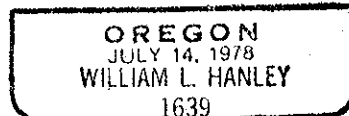

Office of.....County Surveyor.....County of.....Baker.....
 State of.....Oregon....., I hereby certify that the within instrument was filed in this office
 for record on the..... day of....., 19.....

..... by
 (COUNTY OFFICIAL) (DEPUTY)