


CERTIFIED RECORD OF LAND CORNER MONUMENTATION

East center end Bunker Hill Lode MS 329.

History of original corner establishment:

Corner ESTABLISHED by C.M.Foster, U.S. Deputy Mineral Surveyor, under instructions dated November 4, 1896, for the survey of the BUNKER HILL QUARTZ CLAIM, MS 329.

Surveyor General records state: Thence S13°15'E. Along West end line of Gone Case Claim (Unsurveyed). Established Centre end post of claim.

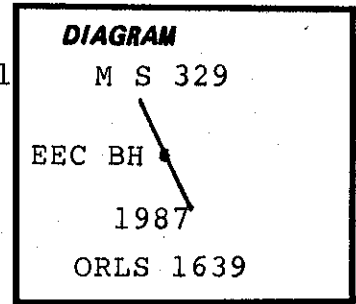

Description of corner evidence found:

Original corner post not found.

A sawed rotting western larch stump 20" dia & 4.8' high brs S27°W, 14.7' dist marked "BT" on remaining blaze. (No record in MS 329 notes for this BT)

Description of monument and accessories I established to perpetuate the original location of this corner:

At midpoint between corner #1 and corner #2 of this claim as determined by survey...

Set 2 " x 30" aluminum pipe with 2½" aluminum cap 25" in ground with 5" projecting out of the ground surrounded with rock mound. Cap marked as shown in corner diagram. Set steel fence post alongside with signs 54-2 & 54-9 attached.

New bearing trees established:

A lodgepole pine 12" dia brs S58°E, 36.0' dist mkd BH-EEC-329 BT.
A lodgepole pine 6" dia brs N78°E, 61.0' dist mkd BH-EEC-329 BT.

New bearing trees have a brass washer stamped PLS 1639 nailed to face of blaze. Attached signs 54-3 & 54-9 and painted face of blaze and 6" band of red paint around each BT.

Compass declination 20° East.

I hereby certify that the above corner monument was properly REESTABLISHED to U.S.F.S. standards by me and witnessed by Bill Gohring on October 29, 1987.

REGISTERED
PROFESSIONAL
LAND SURVEYOR

William L. Hanley

OREGON
JULY 14, 1978
WILLIAM L. HANLEY
1639

Office of.....County Surveyor.....County of.....Baker.....
Oregon
State of....., I hereby certify that the within instrument was filed in this office
for record on the..... day of....., 19.....
..... by
(COUNTY OFFICIAL) (DEPUTY)