


CERTIFIED RECORD OF LAND CORNER MONUMENTATION

West center end Lilac Lode MS 376 identical with East center end Myrtle Lode MS 375.

History of original corner establishment:

Corner ESTABLISHED by John Hagel, U.S. Deputy Mineral Surveyor, under instructions dated September 18, 1899, for the survey of MYRTLE QUARTZ CLAIM, M.S. 375, performed in conjunction with the survey of the LILAC QUARTZ CLAIM, M.S. 376, under instructions dated the same date.

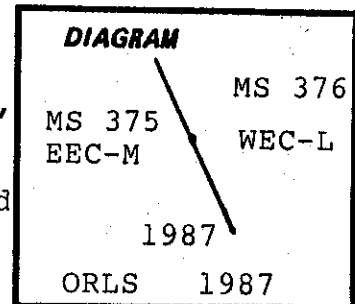

Surveyor General records state: To East Center post (MS 375)...Set a tamarack post 4" square 4½' long 18" in ground with a mound of earth around it, marked it "MYRTLE E.C.S. 375" for East Center post. A black pine 8" dia blazed & marked Myrtle E C Sur 375 BT brs S61°20'W, 24.2'. The upper end of the discovery cut brs N76°25'W, 597.0'...To West Centre post (MS 376)...Identical with East centre post of Myrtle Load Sur 375...A tamarack post 4" square 3' above the ground with a mound of earth around it marked Myrtle E C S 375 marked it "Lilac W C S 376" for West centre post. A red fir tree 9" in diam blazed and marked "Lilac W C S 376 BT" brs S20°45'E, 11.5'. Mouth of tunnel No 3 brs N62°E, 413.0'.

Description of corner evidence found:

No trace of original tamarack post.

A dead lodgepole pine 10" dia brs S61°20'W, 24.2' dist (per record) mkd Myrtle E C S 375 BT, on partially healed blaze inside 1" overgrowth.

A red fir 17" dia brs S20°45'E, 11.5' dist (per record) with fully healed blaze.

Description of monument and accessories I established to perpetuate the original location of this corner:

At position determined by reversed record bearing and distance from recovered original BT's...

Set 12" x 30" aluminum pipe with 2½" aluminum cap 25" in ground with 5" projecting out of the ground surrounded with rock mound. Cap marked as shown in corner diagram. Set steel fence post alongside with signs 54-9 attached.

New bearing trees established:

A 17" douglas fir brs S76°W, 25.8' mkd M-EEC-375 BT.

New bearing trees have a brass washer stamped PLS 1639 nailed to face of blaze. Attached signs 54-3 & 54-9 and painted face of blaze and 6" band of red paint around each BT.

Compass declination 20° East.

I hereby certify that the above corner monument was properly REMONUMENTED to U.S.F.S. standards by me and witnessed by Bill Gohring on November 17, 1987.

REGISTERED
PROFESSIONAL
LAND SURVEYOR

William L. Hanley

OREGON
JULY 14, 1978
WILLIAM L. HANLEY
1639

Office of...County Surveyor...County of...Baker
State of...Oregon...I hereby certify that the within instrument was filed in this office
for record on the..... day of....., 19....

..... by
(COUNTY OFFICIAL)

(DEPUTY)

Form R6-7100-57 (9/71)

☆GPO—798-275

FILED 5-2-88

BAKER COUNTY SURVEYOR

SURVEY NO. 9-36-112