

CERTIFIED RECORD OF LAND CORNER MONUMENTATION


Cor.No.2,Chapman Lode MS382A,identical with Cor.No.3,Rainbow Lode MS447.

History of original corner establishment:

This corner was ESTABLISHED in 1899 by C.M.Foster,U.S.deputy mineral surveyor as follows: To Cor No.2. A fir post 4 ft long 4 ins square, set 18 ins in the ground, scribed 2-382, whence, A fir 16 ins dia bears N8°W, 21 ft dist blazed and scribed 2-382,A, B.T. A fir 12 ins dia bears N44°30'W, 58 ft dist blazed and scribed 2-382,A B.T.

RECOVERED & AMENDED in 1901 by the same C.M.Foster, as follows To Cor.No.3. A pine post 4½ ft long 4 ins square, set 18 ins in the ground, surrounded with a mound of earth scribed

Rainbow - Cor.3-447 and Chapman - Cor.2-382. Identical with angular cor. post of amended location and with cor. post No.2 of the Chapman Lode Mkd. 382.

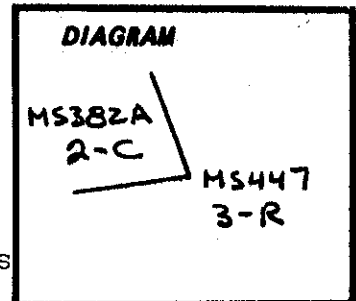


Description of corner evidence found:

None.

Description of monument and accessories I established to perpetuate the original location of this corner:

At position determined by survey (see Record of Survey Plat filed separately for method of corner position reestablishment)...

Set 2" x 30" aluminum pipe with 2½" dia aluminum cap attached 25" in ground surrounded with a mound of earth & stone and placed 6' steel fence post alongside with signs 54-9 attached. Aluminum cap marked as shown to the right...

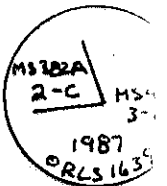

New bearing trees established:

A lodgepole pine 10" diam brs S19½°W, 24.3' dist mkd C-2-382A-R-3-447 BT.
A lodgepole pine 10" diam brs S80°E, 41.4' dist mkd C-2-382A-R-3-447 BT.

Each new bearing tree has signs 54-3 & 54-9 attached below a surrounding 6" band of red paint and has a brass washer marked PLS 1639 nailed flush to red painted blaze.

Compass declination 20° East.

I hereby certify that the above described corner was REESTABLISHED and MONUMENTED to USFS standards by me and witnessed by Bill Gohring on December 16, 1987.

**REGISTERED
PROFESSIONAL
LAND SURVEYOR**

William L. Hanley

**OREGON
JULY 14, 1978
WILLIAM L. HANLEY
1639**

Office of.....County Surveyor.....County of.....Baker.....
State of.....Oregon....., I hereby certify that the within instrument was filed in this office
for record on the..... day of....., 19.....

..... by
(COUNTY OFFICIAL) (DEPUTY)

FILED 5-2-88
BAKER COUNTY SURVEYOR
SURVEY NO. 9-36-113