


CERTIFIED RECORD OF LAND CORNER MONUMENTATION

East center end, Chapman Lode, MS 382 A.

History of original corner establishment:

This corner was ESTABLISHED in 1899 by C.M.Foster, U.S. deputy mineral surveyor, as follows:

To E center end post. A fir post 4 ft long, 4 ins square set 18 ins in the ground scribed E.cen. end post - 382,A, whence, A pine 10 ins dia bears N21°30'W, 13 ft dist blazed and scribed E. cen. end - 382,A. B.T.

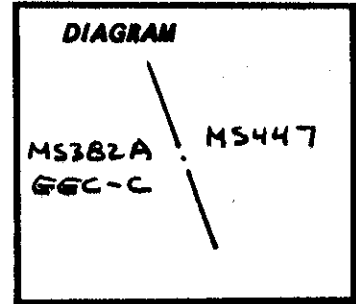

Description of corner evidence found:

None.

Description of monument and accessories | established to perpetuate the original location of this corner:

At position determined by survey (see Record of Survey Plat filed separately for method of corner position reestablishment)...

Set 2" x 30" aluminum pipe with 2½" dia aluminum cap attached 25" in ground surrounded with a mound of earth & stone and placed 6' steel fence post alongside with signs 54-9 attached.

Aluminum cap marked as shown to the right...

New bearing trees established:

A lodgepole pine 13" diam brs S06°E, 24.8' dist mkd C-EEC-382A BT.

A lodgepole pine 9" diam brs S71°E, 31.3' dist mkd C-EEC-382A BT.

Each new bearing tree has signs 54-3 & 54-9 attached below a surrounding 6" band of red paint and has a brass washer marked PLS 1639 nailed flush to red painted blaze.

Compass declination 20° East.

I hereby certify that the above described corner was REESTABLISHED and MONUMENTED to USFS standards by me and witnessed by Bill Gohring on December 16, 1987.

REGISTERED
PROFESSIONAL
LAND SURVEYOR

William L. Hanley

OREGON
JULY 14, 1978
WILLIAM L. HANLEY
1639



Office of...County Surveyor...County of...Baker...
Oregon

State of..., I hereby certify that the within instrument was filed in this office
for record on the...day of..., 19...

by
(COUNTY OFFICIAL) (DEPUTY)