


CERTIFIED RECORD OF LAND CORNER MONUMENTATION

Cor.No.3,Chapman Lode MS 382 A.

History of original corner establishment:

This corner was ESTABLISHED in 1899 by C.M.Foster.
U.S. deputy mineral surveyor, as follows:

To Cor.No.3. A fir post 4 ft long 4 ins square,
set 18 ins in the ground, scribed 3-382, A.
whence, A tamarack 18 ins dia bears N68°30'W,
12 ft dist, blazed and scribed 3-382, A.B.T.
A tamarack 8 ins dia bears S44°20'W, 5 ft dist,
blazed and scribed 3-382,A.B.T.

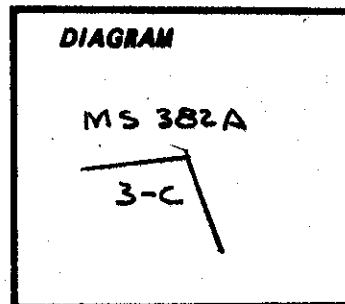


Description of corner evidence found:

None.

Description of monument and accessories I established to perpetuate the original location of this corner:

At position determined by survey (see Record of Survey Plat filed separately for method of corner position reestablishment)...

Set 2" x 30" aluminum pipe with 2½" dia aluminum cap attached 25" in ground surrounded with a mound of earth & stone and placed 6' steel fence post alongside with signs 54-9 & 54-2 attached. Aluminum cap marked as shown to the right...

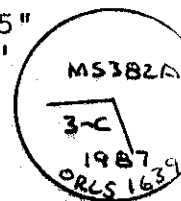



New bearing trees established:

A lodgepole pine 9" diam brs S39°E, 6.5' dist mkd C-3-382A BT.
A lodgepole pine 9" diam brs N80°W, 2.2' dist mkd C-3-382A BT.

Each new bearing tree has signs 54-3 & 54-9 attached below a surrounding 6" band of red paint and has a brass washer marked PLS 1639 nailed flush to red painted blaze.

Compass declination 20° East.

I hereby certify that the above described corner was REESTABLISHED and MONUMENTED to USFS standards by me and witnessed by Bill Gohring on December 17, 1987.

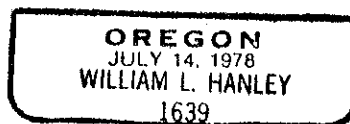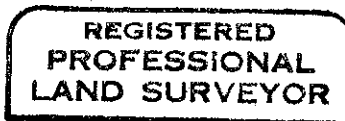

Office of.....County Surveyor..... County of.....Baker.....
State of.....Oregon....., I hereby certify that the within instrument was filed in this office
for record on the..... day of....., 19.....

..... by
(COUNTY OFFICIAL) (DEPUTY)

FILED 5-2-88
BAKER COUNTY SURVEYOR
SURVEY NO. 9-36-115