


CERTIFIED RECORD OF LAND CORNER MONUMENTATION

INDEX MS 813

History of original corner establishment:

- A. William W. Elmer, U.S. Deputy Mineral Surveyor, under Mineral Survey No. 813 surveyed the Elizabeth Dahl claim known as Pioneer, Pacific, and LaCross Lodes from 28 June, to 8 July, 1922 and approved by the U.S. Surveyor General's Office.

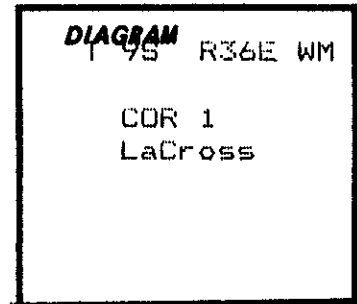

SURVEYOR GENERAL'S RECORD STATES:

A pine post 4.5 ins. square, 4 ft. long, set 1.5 ft. in the ground with mound of earth and stone, scribed 1-813-LaCross, whence 1/4 corner between secs. 2-3, T9S., R36E., W.M. bears S57-49E., 587.2 ft. A forked tamarack 24 ins. dia. bears N36-30W., 40.92 ft. No other bearings available.

Description of corner evidence found:

I found a 4"x4"x19" remains of wood post on surface with partial scribing and found pointed end remains 4"x4"x4" post 18" in the ground.

ACCESSORIES FOUND:

18" dia. Western Larch (dead) with partially healed blaze and scribing bears N36W, 40.6 ft.

Description of monument and accessories I established to perpetuate the original location of this corner:

CORNER WORK DONE ON 6/12/90

- C. At the position of the pointed post remnant, set a 2.5" dia. by 30" long aluminum pipe with a 2.5" dia. aluminum cap. The pipe is set 18" in the ground with a mound of stone to the top. The cap is marked:

1-MS-813
LaCross
1990
STRYKER PLS 2060

NEW ACCESSORIES ESTABLISHED

- 15" dia. Spruce bears N2E, 6.3 ft.; scribed 1 MS 813 LACROSS BT
14" dia. Spruce bears S53W, 31.4 ft., scribed 1 MS 813 LACROSS BT
Painted the blaze red on each BT
Painted a 6" wide red band around each BT
Placed brass washer marked "PLS 2060" at base of each BT blaze
Placed metal sign with bearing and distance information on each BT (54-3)
Placed metal ATTENTION sign on each BT (54-4)
Placed 6 ft. metal guard post at corner with metal PROPERTY BOUNDARY sign and metal ATTENTION sign (54-2 and 54-4)
I measured to the centerline of each bearing tree using tape and hand compass with declination set at 20 degrees east.

Office of..... County of.....
State of....., I hereby certify that the within instrument was filed in this office
for record on the..... day of....., 19.....
..... by
(COUNTY OFFICIAL) (DEPUTY)

