

CERTIFIED RECORD OF LAND CORNER MONUMENTATION

INDEX MS 813

History of original corner establishment:

DIAGRAM

T 9S R36E WM

COR 1
Pacific

- A. William W. Elmer, U.S. Deputy Mineral Surveyor, under Mineral Survey No. 813 surveyed the Elizabeth Dahl claim known as Pioneer, Pacific, and LaCross Lodes from 28 June, to 8 July, 1922 and approved by the U.S. Surveyor General's Office.

SURVEYOR GENERAL'S RECORD STATES:

A fir post 4 ins. square, 4 ft. long, set 1 ft. in the ground, on solid rock with a mound of earth and stone, scribed 4-813-PIONEER, whence
A red fir 6 ins. dia. bears S20E., 41 ft., and a red fir 30 ins. dia. bears S56E., 69.1 ft. each blazed and scribed 4-813-PIONEER BT.
Identical with Cor. No. 4, Pioneer lode of this survey, previously described, which with the bearing trees I scribed 1-813-PAC., whence
the corner common to Secs. 34-35, T8S and Secs. 2-3, T9S, R36E, WM, bears N43-26E., 897.54 ft.

Description of corner evidence found:

B. MONUMENT FOUND:

None; position falls on exposed bedrock slope.


ACCESSORIES FOUND:

30" dia. true fir blowdown bole with visible scribe of "BT" on steep rocky hillside. The centerline of root hole bears S56E at 69.1 ft.
6" dia. true fir blowdown root wad and short bole with visible scribe of "4 813 P" on steep rocky hillside. Its origin could not be located.

Description of monument and accessories I established to perpetuate the original location of this corner:

CORNER WORK DONE ON 6/19/90

- C. At the locus of reversed bearing and distance set a 2.5" dia. by 30" long aluminum pipe with a 2.5" dia. aluminum cap. The pipe is set on bedrock with large rock mound to 1" of the top.
Cap is marked

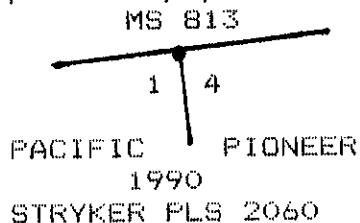

NEW ACCESSORIES ESTABLISHED

13" dia. Ponderosa Pine bears S21W, 35.4 ft.; scribed MS813 4 PION 1 PACIFIC BT
11" dia. Grand Fir bears N1W, 50.3 ft., scribed MS813 4 PION 1 PAC BT
Painted the blaze red on each BT
Painted a 6" wide red band around each BT
Placed brass washer marked "PLS 2060" at base of each BT blaze
Placed metal sign with bearing and distance information on each BT (54-3)
Placed metal ATTENTION sign on each BT (54-4)
Placed 6 ft. metal guard post at corner with metal PROPERTY BOUNDARY sign and metal ATTENTION sign (54-2 and 54-4)
I measured to the centerline of each bearing tree using tape and hand compass with declination set at 20 degrees east.

Office of..... County of.....
State of....., I hereby certify that the within instrument was filed in this office
for record on the..... day of....., 19.....
..... by
(COUNTY OFFICIAL) (DEPUTY)

REGISTERED
PROFESSIONAL
LAND SURVEYOR

Edwin A. Stryker
OREGON
JULY 15, 1983
EDWIN A. STRYKER
2060