


CERTIFIED RECORD OF LAND CORNER MONUMENTATION

INDEX MS 813

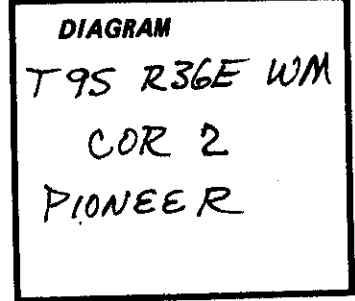


History of original corner establishment:

HISTORY CONT.

whence,
A pine the original bearing tree now 22 ins. dia., bears N8-55E, 34.53 ft
A red fir the original bearing tree now 12 ins. dia. bears S78-40E, 38.12
ft, each blazed and scribed BT GH 2 485, and which I scribed
2 813 PIONEER

Description of corner evidence found:

Description of monument and accessories I established to perpetuate the
original location of this corner:

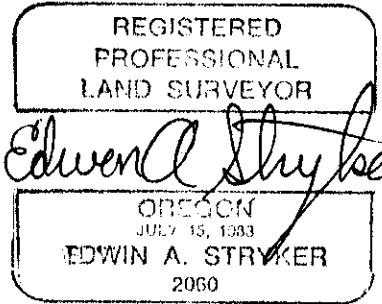

Office of..... County of.....
State of....., I hereby certify that the within instrument was filed in this office
for record on the..... day of....., 19.....
..... by
(COUNTY OFFICIAL) (DEPUTY)