

CERTIFIED RECORD OF LAND CORNER MONUMENTATION

INDEX MS 813

History of original corner establishment:

- A. William W. Elmer, U.S. Deputy Mineral Surveyor, under Mineral Survey No. 813 surveyed the Elizabeth Dahl claim known as Pioneer, Pacific, and LaCross Lodes from 28 June, to 8 July, 1922 and approved by the U.S. Surveyor General's Office.

DIAGRAM

T 9S R36E WM

COR 2

Pioneer

SURVEYOR GENERAL'S RECORD STATES:***CONT. NEXT PAGE**

Identical with Cor. No. 2, Sur. No. 485, Gold Hill lode, claimants Peter D. Estes and Joseph D. Young. A post 4 ins. square, 3.5 ft. long, decayed at the bottom was found lying on the ground with one end in a mound of earth and stone, scribed GH 2 485, which I replaced with a new pine post, 4 ins. square at the top, 4 ft. long, set 1.5 ft. in the ground, in the center of the original mound of earth and stone, and scribed GH 2 485 2 813 PIONEER

Description of corner evidence found:

B. MONUMENT FOUND:

None


ACCESSORIES FOUND:

30" dia. Ponderosa Pine bears N17E, 34.6 ft., with partially healed blaze and visible scribe of "H 2 485 813"
24" dia. Douglas fir bears S70E, 38.1 ft. with healed blaze. (did not open)

Description of monument and accessories I established to perpetuate the original location of this corner:

CORNER WORK DONE ON 6/14/90

- C. At the locus of distance-distance (bearings weak) from the bearing trees I set a 2.5" dia. by 30" long aluminum pipe with a 2.5" dia. aluminum cap. The pipe is set in the toe of jeep road fill. Mounded stones to 2" of the top and placed large slab rock on fill to protect monument. Cap is marked

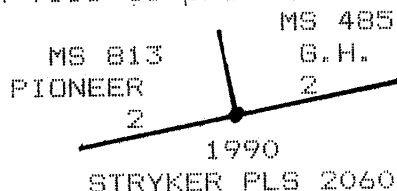

NEW ACCESSORIES ESTABLISHED

None; both original BT's are healthy

Painted the blaze red on each BT
Painted a 6" wide red band around each BT
Placed brass washer marked "PLS 2060" at base of each BT blaze
Placed metal sign with bearing and distance information on each BT (54-3)
Placed metal ATTENTION sign on each BT (54-4)
Placed 6 ft. metal guard post at corner with metal PROPERTY BOUNDARY sign and metal ATTENTION sign (54-2 and 54-4)
I measured to the centerline of each bearing tree using tape and hand compass with declination set at 20 degrees east.

Office of..... County of.....
State of....., I hereby certify that the within instrument was filed in this office
for record on the..... day of....., 19....

..... by
(COUNTY OFFICIAL) (DEPUTY)

REGISTERED
PROFESSIONAL
LAND SURVEYOR

Edwin A. Stryker

OREGON
JULY 15, 1983
EDWIN A. STRYKER
2060

Form R6-7100-57 (9/71)

GPO-798-276

FILED 11-16-1990

BAKER COUNTY SURVEYOR

SURVEY NO. 9-36-131