


ROS 9-36-107 B. HANLEY
MAGNETIC DECL. 20 EAST

HISTORY OF SURVEYS-NARRATIVE

John Hagel, U.S. Deputy Mineral Surveyor, under Mineral Survey No. 375, surveyed the Fred Knuthetal claim known as MYRTLE QUARTZ CLAIM in September, 1899 and it was approved by the U.S. Surveyor General's Office October, 31, 1899. William Hanley, ORLS 1639, under U.S.F.S. contract 43-04M3-7-6123, surveyed the common boundary between MYRTLE CLAIM and LILAC CLAIM (MS-376) as recorded in Baker County Surveyor's Office 5-2-88. I recovered original evidence at corners 3, 4, 5, and west center locations, and monumented those positions. A closed loop traverse was run through the corners and the claim. Land corner recordation forms have been filed with the Baker County Surveyor's Office as part of this survey for these recovered corners. The survey was performed at the request of the U.S. Forest Service.

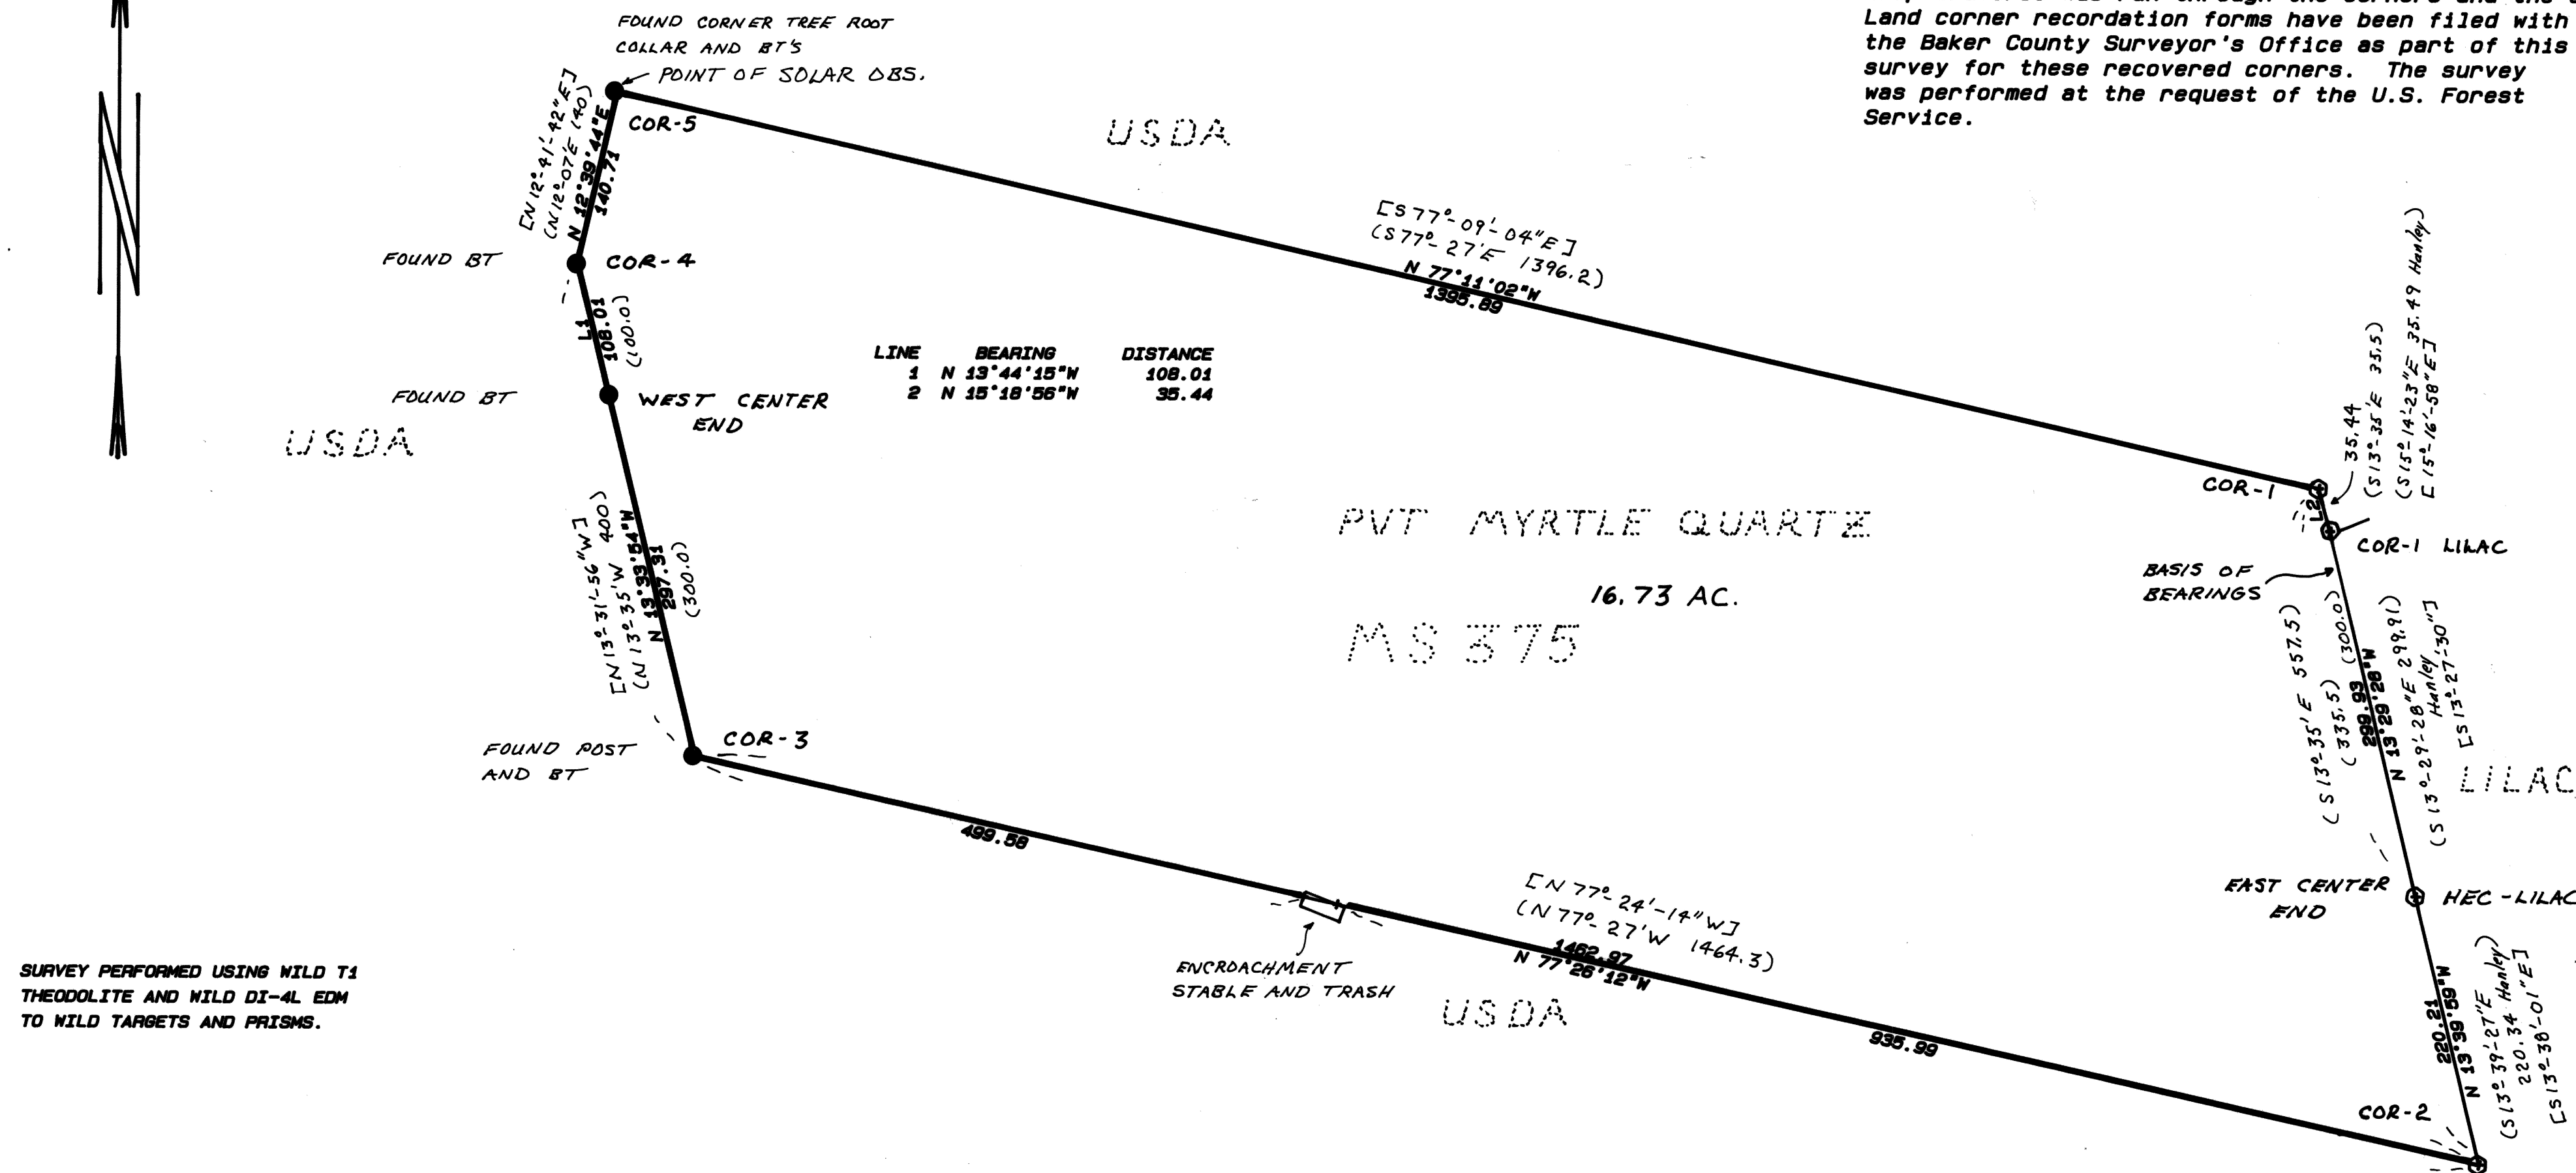

LEGEND

- (G) FOUND 2.5 INCH DIA. ALUM. MON. OF RECORD
 (●) SET 2.5 INCH DIA. BY 30 INCH ALUM. MON.
 _____ PROPERTY LINE ESTABLISHED AND POSTED
 (**.*) SURVEY DATA OF RECORD
 [°-'-"] BEARING BY SOLAR OBSERVATION

EXAMINED AND ACCEPTED FOR THE U.S. FOREST SERVICE
THIS 24th DAY OF October 1990.
Richard A. Chebro COR.

I CERTIFY THAT THIS SURVEY WAS PERFORMED AT THE REQUEST OF THE WALLAWA-WHITMAN NATIONAL FOREST SUPERVISOR.

R. M. Richmond 10/25/90
SIGNATURE DATE

100 50 0 100 200 300

SCALE IN FEET

FILED 11-16-1990
BAKER COUNTY SURVEYOR
SURVEY NO. 9-36-132

FILED FOR RECORD THIS ____ DAY OF _____, 19____,
AS SURVEY NUMBER _____,
RECORDS OF BAKER COUNTY, STATE OF OREGON.

DEPUTY SURVEYOR

COUNTY SURVEYOR

I, EDWIN A. STRYKER, REGISTERED LAND SURVEYOR IN THE STATE OF OREGON, HEREBY CERTIFY THAT THIS PLAT AND THE NOTES HEREON, OR ATTACHED, ARE A TRUE AND CORRECT REPRESENTATION OF THE SURVEY I MADE IN JUNE-JULY 1990, AT THE REQUEST OF THE USDA FOREST SERVICE IN ACCORDANCE WITH THE STATUTES OF THE STATE OF OREGON AND THE ARTICLES OF MY CONTRACT NUMBER 04M3-9-6056 .

REGISTERED
PROFESSIONAL
LAND SURVEYOR

Edwan A Stryker

OREGON
JULY 15, 1983
EDWIN A. STRYKER
2060

STRYKER-KIMBELL ASSOCIATES

67918 HUNTER ROAD
SUMMERVILLE, ORE 97876
(503) 534-6905

DRAWN HP7575A

JOB NO 0689030936

DATED 8-25-90

CHECKED BY EAS

SCALE 1 in. = 100

SHEET 1 OF 5