


WITHIN
SEC. 3, T.9S., R.36E., W.M.

DECL
20° E

William Wells. QRS No. 1106, retraced the Three Star Mining Claim, in 1986, under contract to the US Forest Service, and remonumented the claim corners per record of survey number 9-36-45, records of Baker County Surveyor's Office. The purpose of my survey was to tie the existing road location to the monumented and posted boundary of said claim, so that right-of-way could be pursued by the Forest Service. I recovered W. Wells remonumented corners and these corners form the basis of this survey. My survey was a closed loop survey along the boundary of the Three Star mineral claim through said corners, using a WILD T1 theodolite and WILD DI-4L EDM. The existing centerline of native surface road was tied using a Topcon GTS-2R theodolite as part of this survey. The intersection of the mineral survey boundary and the existing road centerline was monumented to contract specifications, for the purpose of right-of-way. The survey was performed at the request of the USDA Forest Service.

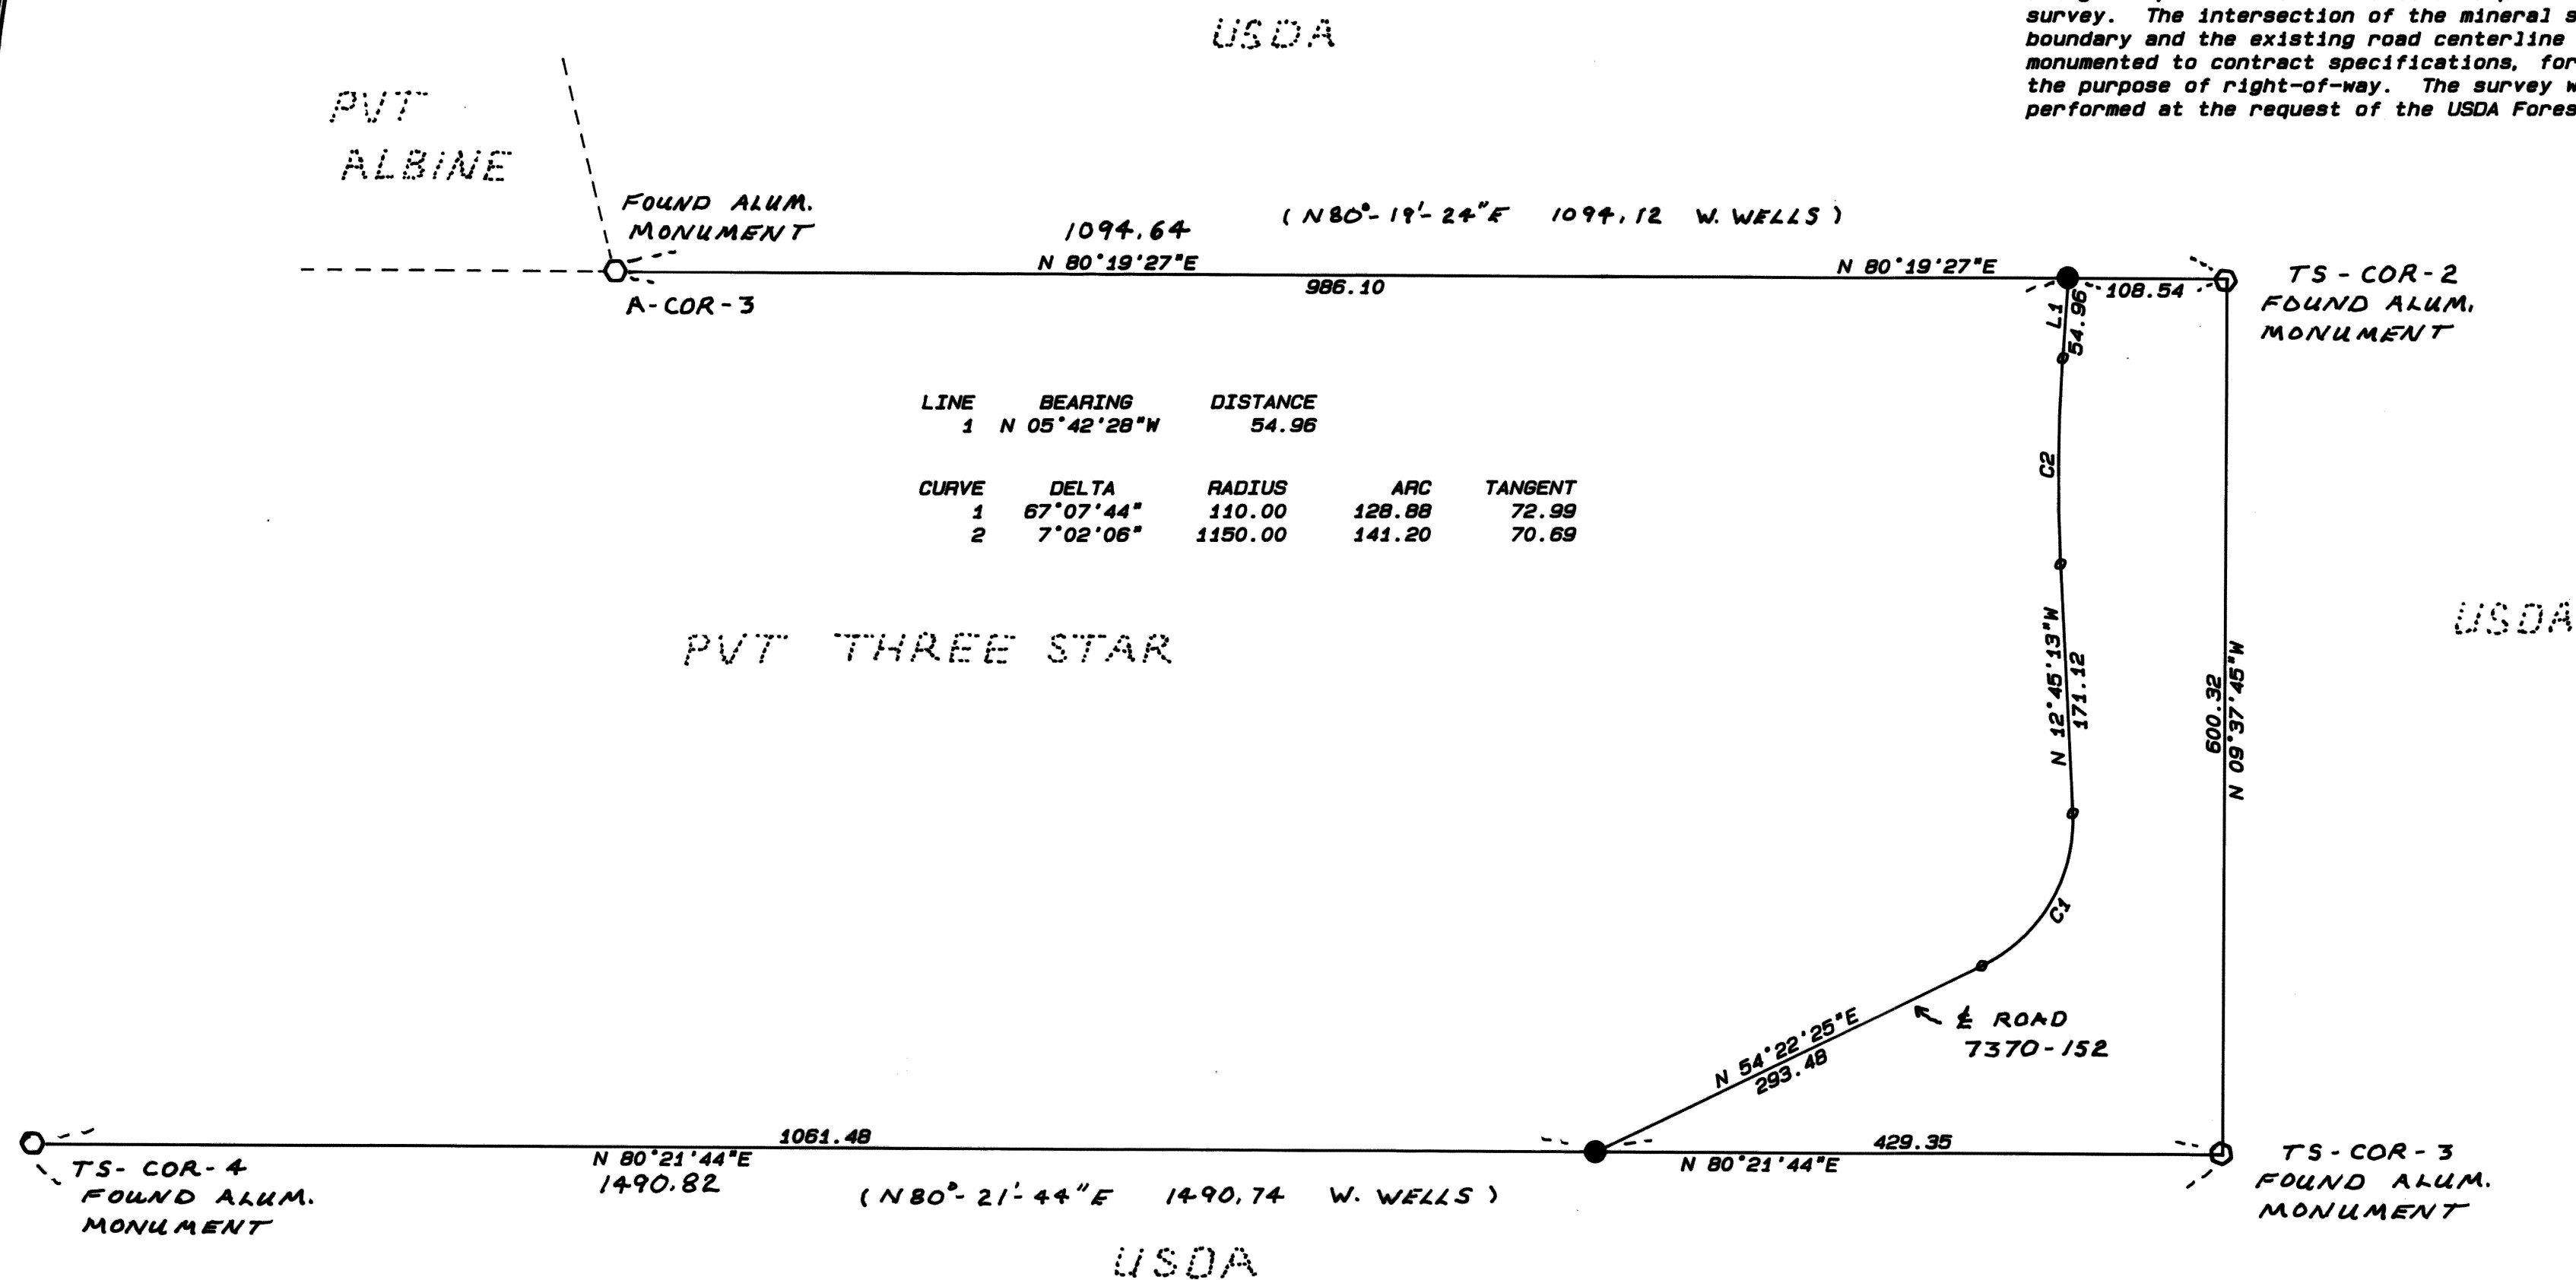

FILED 11-16-1990
BAKER COUNTY SURVEYOR
SURVEY NO. 9-36-135

○ FOUND MONUMENT OF RECORD
● SET #5 Rebar with 1.5 inch
dia. aluminum cap-PLS 2060
(**)** SURVEY DATA OF RECORD

CONTRACT NO.: 04M3-9-6056

Edwin A Stryker
OREGON
JULY 15, 1983
EDWIN A. STRYKER
2060

**67918 HUNTER ROAD
SUMMERVILLE, ORE 97876
(503) 534-6905**

<i>DRAWN HP7575A</i>	<i>JOB NO 0689030936</i>	<i>DATED 8-25-90</i>
<i>CHECKED BY EAS</i>	<i>SCALE 1 in. = 100</i>	<i>SHEET 4 OF 5</i>