


CERTIFIED RECORD OF LAND CORNER MONUMENTATION

History of original corner establishment:

Set 4" x 4" post from which a:

14" Fir bears S 60° E 81 lks dist.
10" Larch bears S 35° W 75 lks dist.

Set from 1882 survey by William R. Gradon under contract
by the General Land Office

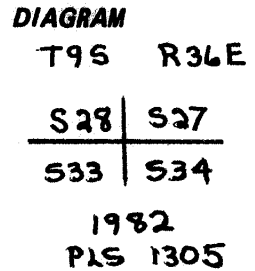

Description of corner evidence found:

22" D. Fir bears S 60° E 53.5 ft.- healed blaze
15" Larch bears S 35° W 49.5 ft. - visible scribing

Description of monument and accessories I established to perpetuate the
original location of this corner:



Set 2½" brass cap in 2½" x 30" G.I. pipe with flared base - rock mound,
marked as per diagram above

Scribed BTs:

14" D. Fir bears N 66° W 6.2 ft., scribed T9S, R36E S28 BT
12" D. Fir bears N 26° E 15.2 ft., scribed T9S, R36E S27 BT
8" W. Fir bears S 41° W 8.8 ft., scribed T9S, R36E S23 BT

I hereby certify the above corner monument was
re-established as herein described on August 16, 1982

Witnesses: Dave Dean
Pat Smith

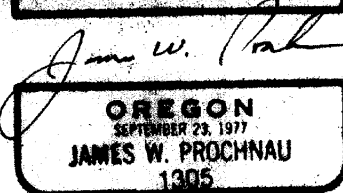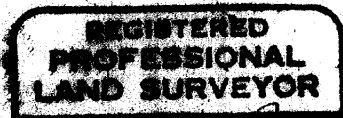

Office of..... County of.....

State of....., I hereby certify that the within instrument was filed in this office
for record on the..... day of....., 19.....

..... by
(COUNTY OFFICIAL) (DEPUTY)