

CERTIFIED RECORD OF LAND CORNER MONUMENTATION

**History of original corner establishment:**

Original Survey by William R. Gradon under contract # 409 dated March 28, 1882

Set a basalt stone 18x8x8 ins 12 ins in the ground for  $\frac{1}{4}$  sec cor marked  $\frac{1}{4}$  on W face from which

A pine 14 ins diam bears N20° E 22 lks dist marked  $\frac{1}{4}$  S BT  
A pine 14 ins diam bears S85° W 24 lks dist marked  $\frac{1}{4}$  S BT

**DIAGRAM**

T9S R36E  
S32 | S33

**Description of corner evidence found:**

At the corner location I could find no evidence of the original stone. This is on a steep side slope and it may have rolled down the hill.

The S85° W BT is a standing live 18" Ponderosa pine with a partially healed over scar marked  $\frac{1}{4}$  S at a distance of 15.8 ft. The N20° E BT is a dead and down Ponderosa pine that has been transported by cat about 150 ft from its original position probably during road construction 50 ft East of corner

**Description of monument and accessories I established to perpetuate the original location of this corner:**

From the remaining solid BT I set a 2 $\frac{1}{2}$ "x32" Brass capped steel pupe 20" in the ground in a mound of earth and rock from which:  
A 6" White Fir bears S16° E 23.73 ft  
mkd  $\frac{1}{4}$  S 33 BT nail in NE base  
An 18" Ponderosa pine bears S85° W 15.8 ft  
mkd  $\frac{1}{4}$  S BT Original B.T.


Bearings taken with a staff compass  
declination 18 $\frac{1}{2}$ ° East per 1980 Isogonic chart.

Distance pulled to 60d nail with Brass washer stamped LS 1898 driven in the side center of bearing trees

I hereby certify the above corner monument was re-established as wherein described on 19 July 1983

**MONUMENT STAMPED**

T9S R 36E  
 $\frac{1}{4}$   
S32 | S33  
1983  
ORLS 1898

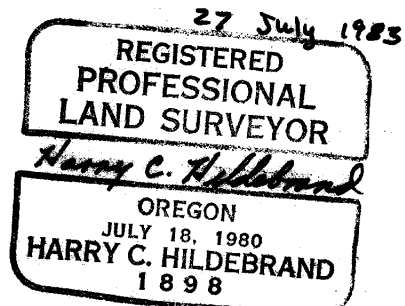

Office of.....Surveyor..... County of.....Baker.....  
State of.....Oregon....., I hereby certify that the within instrument was filed in this office  
for record on the..... day of....., 19.....  
..... by .....  
(COUNTY OFFICIAL) (DEPUTY)