

CERTIFIED RECORD OF LAND CORNER MONUMENTATION

History of original corner establishment:

Original survey by William R. Gradon under contract
409 dated March 28 1882

Set a post 3 ft long 3 ins square 24 ins in the
ground for $\frac{1}{4}$ sec cor marked $\frac{1}{4}$ S on W face from which

A Tamarack 12 ins diam bears East 50 lks dist
marked $\frac{1}{4}$ S BT

A Fir 15 ins diam bears S70° W 18 lks dist
marked $\frac{1}{4}$ S BT

DIAGRAM

T 9 S R 36 E

S31 | S32

Description of corner evidence found:

At the corner location I found no evidence of the original post.

I found a 13" Tamarack bearing S88° E at a distance of 33 ft
marked $\frac{1}{4}$ S BT

I found a 24" Fir bearing S70° W at a distance of 11.9 ft marked
 $\frac{1}{4}$ S BT

**Description of monument and accessories I established to perpetuate the
original location of this corner:**

Set a 2 $\frac{1}{2}$ x32" Brass capped Steel pipe 22" in the
ground in a mound of stone. The two original BTs are standing and
in good condition so I set no new ones.

I hereby certify the above corner monument
was re-established as herein described on
June 22, 1983


Monument Stamped

T9S R36E

$\frac{1}{4}$
S31 | S32

1983

ORLS 1898

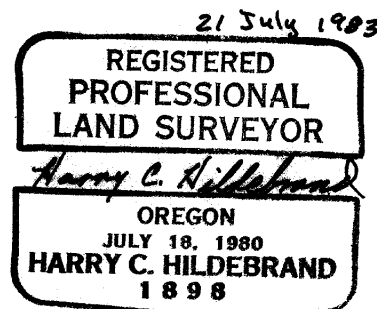

Office of.....Surveyor..... County of.....Baker.....
State of.....Oregon....., I hereby certify that the within instrument was filed in this office
for record on the..... day of....., 19.....

..... by
(COUNTY OFFICIAL) (DEPUTY)

Form R6-7100-57 (9/71)

FILED July 28, 1983
BAKER COUNTY SURVEYOR
SURVEY NO. 9-36-20

☆ GPO—798-276
X-05