

CERTIFIED RECORD OF LAND CORNER MONUMENTATION

History of original corner establishment:

Original survey by William R. Gradon under contract No. 409 dated March 28, 1882.

Set a post 3ft long 3ins square 24ins in the ground for $\frac{1}{4}$ sec. cor. marked $\frac{1}{4}$ S on N face from which

A Fir 4ins diam bears N 10° E 8 lks dist.
marked $\frac{1}{4}$ S BT
A Fir 10ins diam bears S 5° E 8 lks dist.
marked $\frac{1}{4}$ S BT

Description of corner evidence found:

At the corner location there is no evidence of the original post.
A 12" Fir bears N 10° E 5.3ft. standing and living marked "BT".
A 21" Fir bears S 5° E 5.3ft. standing and living with healed over blazes.

Description of monument and accessories I established to perpetuate the original location of this corner:

At the intersect of the bearing tree distances I set a 2 $\frac{1}{2}$ " X 32" Aluminum capped Aluminum pipe 24" in the ground in a mound of earth from which

A 6" White Fir bears N $22^{\circ} 30'$ W 37.23ft.
marked $\frac{1}{4}$ S22 BT nail in S base.
A 7" White Fir bears S 54° W 18.59ft.
marked $\frac{1}{4}$ S27 BT nail in W base.

Bearings taken with a staff compass declination 18 $\frac{1}{2}^{\circ}$ East per 1980 Isogonic chart.

Distances pulled to 60d nail with Brass washer stamped LS 1898 driven in the side center of the bearing trees.


I herby certify that the above monument was re-established as herein described on October 17, 1983.

DIAGRAM

T 9 S R 36 E
S 22
 $\frac{1}{4}$ —————
S 27

MONUMENT STAMPED

T 9 S R 36 E
S 22
 $\frac{1}{4}$ —————
S 27
1983
O.R.L.S. 1898

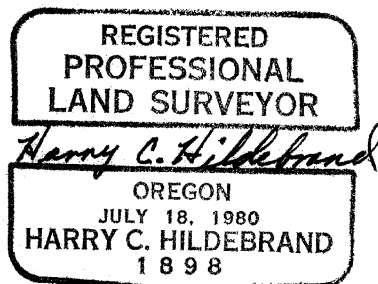

Office of.....Surveyor..... County of.....Baker.....
State of.....Oregon....., I hereby certify that the within instrument was filed in this office
for record on the..... day of....., 19.....
..... by
(COUNTY OFFICIAL) (DEPUTY)